

MISSISSIPPI DEPARTMENT OF NATURAL RESOURCES

Bureau of Land and Water Resources

Southport Mall

P.O. Box 10631

Jackson, Mississippi 39209

WATER WELL DRILLERS LOG

CODED

Harrison
C 225
April 22 1982 Broden Pump & Well Dr. Harrison
 date well completed firm name county well located

LANDOWNER: <u>Ricky Barbours</u>	description of formations encountered	from	to
<u>Pt. 2 Barbours Rd</u>	<u>Clay</u>	<u>0</u>	<u>50</u>
<u>Saucier, Miss 39594</u> (mailing address)	<u>Sand</u>	<u>80</u>	<u>90</u>
WELL LOCATION: sec. <u>8</u> T. <u>5</u> N. R. <u>11</u> E.	<u>Blue Clay</u>	<u>90</u>	<u>140</u>
<u>2</u> miles <u>SE</u> of <u>Saucier</u> (distance) (direction) (nearest town)	<u>Grey Sand</u>	<u>140</u>	<u>220</u>
WELL PURPOSE: <u>Home</u> (home, irrigation, municipal, industrial)			
WELL COMPLETION DATA:			
(1) diameter (inches) <u>2"</u>			
(2) total depth (feet) <u>220</u>			
(3) static water level (feet) <u>72</u> below top of ground.			
(4) casing <u>PVC 210</u> (material) (depth) <u>2"</u> (size) if telescope see back.			
(5) screen <u>PVC 210</u> (length) (depth to top) <u>2"</u> <u>PVC 1008</u> (size) (material)			
(6) pump <u>1</u> <u>10</u> (HP) (yield gpm) <u>220V-1Ø</u> (type power)			
(7) electric log <u>No</u> (yes or no)			
(organization running log)			
(8) how well bottom plugged <u>Pvc Sand Shred</u>			
DRILLERS REMARKS:			

CODED


DEPT. OF NATURAL RESOURCES
 BUREAU OF LAND & WATER RESOURCES

JUL 29 1982

RECEIVED

If well telescopes please sketch and show depths.

GROUND LEVEL

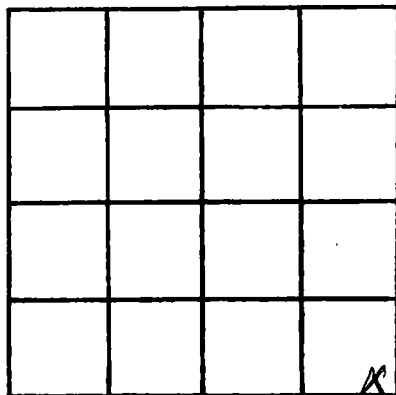

SECTION 8

Please indicate well location X.

ADDITIONAL INFORMATION

If more than one screen, show locations of each on sketch.