

MISSISSIPPI DEPARTMENT OF NATURAL RESOURCES

Bureau of Land and Water Resources

Southport Mall

P.O. Box 10631

Jackson, Mississippi 39209

WATER WELL DRILLERS LOG

15

CODED

|                 |
|-----------------|
| <i>Harrison</i> |
| <i>C 226</i>    |
|                 |
|                 |

*1-29* 19*82* *Discon Well Drilling* *Harrison*  
 date well completed firm name county well located

LANDOWNER: *Ernest Richardson*  
*Rt. 1 Box 268*  
*Southport, Ms. 39501*  
 (mailing address)

| description of formations encountered | from      | to         |
|---------------------------------------|-----------|------------|
| <i>united Sand-Clay</i>               | <i>0</i>  | <i>75</i>  |
| <i>Blue Clay</i>                      | <i>75</i> | <i>80</i>  |
| <i>course Sand</i>                    | <i>80</i> | <i>100</i> |

WELL LOCATION:  
 sec *21* T *S* N R *11* E  
*5* miles *S.E.* of *Harrison*  
 (distance) (direction) (nearest town)

WELL PURPOSE: *Home*  
 (home, irrigation, municipal, industrial)

CODED

WELL COMPLETION DATA:

(1) diameter (inches) *2"*

(2) total depth (feet) *100 ft.*

(3) static water level (feet) *20'* below above top of ground.

(4) casing *PVC* *90'*  
 (material) (depth)

(size) If telescope see back.

(5) screen *10'* *90'*  
 (length) (depth to top)

*2"* *PVC*  
 (size) (material)

(6) pump \_\_\_\_\_ (HP) \_\_\_\_\_ (yield gpm)

(type power)

(7) electric log \_\_\_\_\_ (yes or no)

(organization running log)

(8) how well bottom plugged *Sand*  
*Shale*

DEPT. OF NATURAL RESOURCES  
BUREAU OF LAND & WATER RESOURCES


AUG 30 1982

RECEIVED

DRILLERS REMARKS:  
*Owner had his own pump*

If well telescopes please sketch and show depths.

GROUND LEVEL

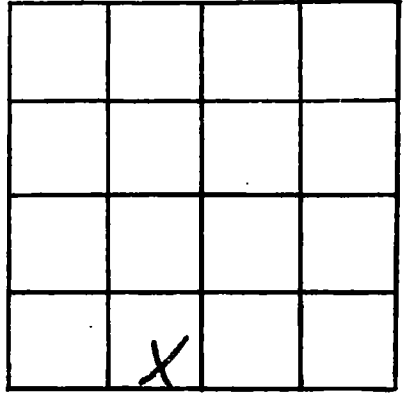

SECTION 21

Please indicate well location X.

**ADDITIONAL INFORMATION**

A series of 20 horizontal lines for writing additional information.

If more than one screen, show locations of each on sketch.