

MISSISSIPPI DEPARTMENT OF NATURAL RESOURCES

Bureau of Land and Water Resources

Southport Mall

P.O. Box 10631

Jackson, Mississippi 39209

WATER WELL DRILLERS LOG

Harrison  
C 22 7

CODED

March 23 1982 Duncan Well Drilling Harrison  
 date well completed firm name county well located

LANDOWNER: Don Lewis  
Rt. 3 Box 449  
Saucier, Ms.  
 (mailing address)

description of formations encountered

from

to

Sand	0	45
Bedclay	45	90
Coarse Sand	90	110

WELL LOCATION:  
 sec. 18 T. 5 N. R. 11 E.  
2 miles (distance) SW (direction) of Saucier (nearest town)

WELL PURPOSE: Home  
 (home, irrigation, municipal, industrial)

CODED

WELL COMPLETION DATA:

(1) diameter (inches) 2"

(2) total depth (feet) 110 ft.

(3) static water level (feet) 20' below above top of ground.

(4) casing PVC (material) 100' (depth)  
 (size) If telescope see back.

(5) screen 10' (length) 100' (depth to top)  
2" (size) PVC (material)

(6) pump (HP) (yield gpm)  
electric (type power)

(7) electric log (yes or no)  
 (organization running log)

(8) how well bottom plugged Sand  
Shank

DRILLERS REMARKS: Owner installed his own pump


DEPT. OF NATURAL RESOURCES  
 BUREAU OF LAND & WATER RESOURCES

AUG 30 1982

RECEIVED

If well telescopes please sketch and show depths.

GROUND LEVEL

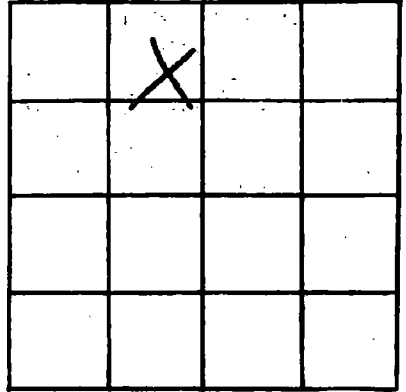

SECTION 18

Please indicate well location X.

ADDITIONAL INFORMATION

If more than one screen, show locations of each on sketch.