

MISSISSIPPI DEPARTMENT OF NATURAL RESOURCES

Bureau of Land and Water Resources

Southport Mall

P.O. Box 10631

Jackson, Mississippi 39209

WATER WELL DRILLERS LOG

CODED

Harrison  
Q 228

March 24 1982 Duncan Well Drilling Harrison  
 date well completed firm name county well located

LANDOWNER: Charles Morris  
Rt. 2 Box 8228  
Saucier, Ms.  
 (mailing address)

description of formations encountered	from	to
<u>sand</u>	<u>0</u>	<u>45</u>
<u>clay</u>	<u>45</u>	<u>85</u>
<u>Course Sand</u>	<u>85</u>	<u>100</u>

WELL LOCATION:  
 sec. 18 T. 5 N. R. 12 E.  
2 miles SE of Saucier  
 (distance) (direction) (nearest town)

WELL PURPOSE: None  
 (home, irrigation, municipal, industrial)

WELL COMPLETION DATA:  
 (1) diameter (inches) 2"  
 (2) total depth (feet) 100 ft.  
 (3) static water level (feet) 20' below/above top of ground.  
 (4) casing pvc 90'  
 (material) (depth)  
 (size) If telescope see back.  
 (5) screen 10' 90'  
 (length) (depth to top)  
 (size) (material)  
 (6) pump (HP) (yield gpm)  
electric  
 (type power)  
 (7) electric log (yes or no)  
 (organization running log)

(8) how well bottom plugged Sand  
shank

DRILLERS REMARKS: Owner  
installed his  
own pump

CODED


DEPT. OF NATURAL RESOURCES  
 BUREAU OF LAND & WATER RESOURCES

AUG 30 1982

RECEIVED

If well telescopes please sketch and show depths.

GROUND LEVEL

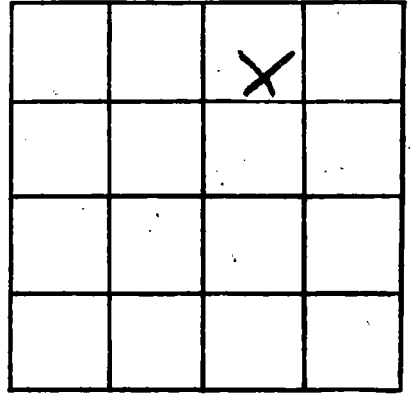

SECTION 18

Please indicate well location X.

ADDITIONAL INFORMATION

Lined area for additional information.

If more than one screen, show locations of each on sketch.