

MISSISSIPPI DEPARTMENT OF NATURAL RESOURCES

Bureau of Land and Water Resources

CODED

Southport Mall

P.O. Box 10631

Jackson, Mississippi 39209

WATER WELL DRILLERS LOG

Harrison
C 229

April 14 1982 Duncan Well Drilling, Harrison
 date well completed firm name county well located

LANDOWNER: Mary Gillespie
Rt. 1 Box 268
Gulfport Ms.
 (mailing address)

description of formations encountered	from	to
Mud & Sand	0	20
Clay	20	30
Sand & Clay	30	75
Course Sand	75	100

WELL LOCATION:
 sec 21 T S N R 11 E
5 miles SE of Harrison
 (distance) (direction) (nearest town)

CODED

WELL PURPOSE: Home
 (home, irrigation, municipal, industrial)

WELL COMPLETION DATA:

- (1) diameter (inches) 2"
- (2) total depth (feet) 100 ft.
- (3) static water level (feet) 15' below above top of ground.
- (4) casing PVC, 90'
 (material) (depth)
- (size) if telescope see back.
- (5) screen 10', 90'
 (length) (depth to top)
- 2", PVC
 (size) (material)
- (6) pump _____ (HP) _____ (yield gpm)
electric
 (type power)
- (7) electric log _____
 (yes or no)

(organization running log)

(8) how well bottom plugged Sand
Mark

DRILLERS REMARKS: owner had his own pump.


DEPT. OF NATURAL RESOURCES
 BUREAU OF LAND & WATER RESOURCES

AUG 30 1982

RECEIVED

If well telescopes please sketch and show depths.

GROUND LEVEL

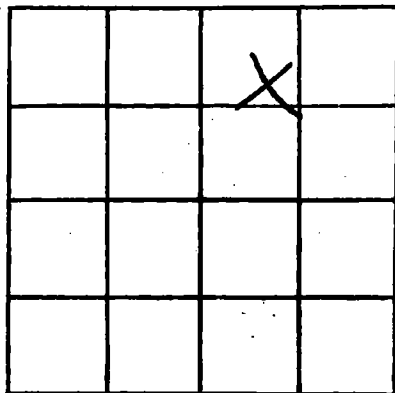

SECTION 21

Please Indicate well location X.

ADDITIONAL INFORMATION

Multiple horizontal lines for writing additional information.

If more than one screen, show locations of each on sketch.