

MISSISSIPPI DEPARTMENT OF NATURAL RESOURCES

Bureau of Land and Water Resources

Southport Mall

P.O. Box 10631

Jackson, Mississippi 39209

WATER WELL DRILLERS LOG

CODED

Harrison  
C 230

June 30 1982 Duncan Well Drilling (Harrison) county well located

LANDOWNER: Barry Kales  
Rt. 2 Box 29 J  
Saucier Ms.  
 (mailing address)

description of formations encountered	from	to
<u>Sand</u>	<u>0</u>	<u>40</u>
<u>Sand + Clay</u>	<u>40</u>	<u>95</u>
<u>Blue Clay</u>	<u>95</u>	<u>160</u>
<u>fine Sand</u>	<u>160</u>	<u>190</u>
<u>course Sand</u>	<u>190</u>	<u>210</u>

WELL LOCATION:  
 sec. 20 T. 5 N. R. 11 E.  
 (S) (W)  
6 miles S.E. of Saucier  
 (distance) (direction) (nearest town)

WELL PURPOSE: Home  
 (home, irrigation, municipal, industrial)

- WELL COMPLETION DATA:
- (1) diameter (inches) 2"
  - (2) total depth (feet) 210 ft.
  - (3) static water level (feet) 30' below above top of ground.
  - (4) casing pvc 200'  
 (material) (depth)  
 (size) If telescope see back.
  - (5) screen 10' 200'  
 (length) (depth to top)  
2" pvc  
 (size) (material)
  - (6) pump 1 12  
 (HP) (yield gpm)  
electric  
 (type power)
  - (7) electric log                       
 (yes or no)  
 (organization running log)
  - (8) how well bottom plugged Sand  
Mark

CODED

DEPT. OF NATURAL RESOURCES  
 BUREAU OF LAND & WATER RESOURCES


AUG 30 1982

RECEIVED

DRILLERS REMARKS:

If well telescopes please sketch and show depths.

GROUND LEVEL

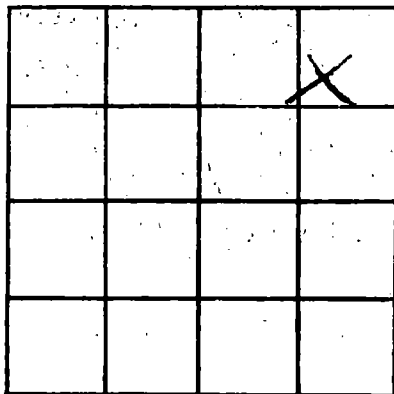

SECTION 20

Please indicate well location X.

ADDITIONAL INFORMATION

If more than one screen, show locations of each on sketch.