

MISSISSIPPI DEPARTMENT OF NATURAL RESOURCES

Bureau of Land and Water Resources

Southport Mall

P.O. Box 10631

Jackson, Mississippi 39209

WATER WELL DRILLERS LOG

Harrison
C 231

CODED

Aug. 18 1982
 date well completed

Duncan Well Drilling Harrison
 firm name

county well located

LANDOWNER: J. Helen Saucier
Spurley Road, Rt. 2
Box 779-D
Saucier, Mo
 (mailing address)

description of formations encountered	from	to
<u>Mud & Sand</u>	<u>0</u>	<u>65</u>
<u>Blue Clay</u>	<u>65</u>	<u>90</u>
<u>Clay & Sand</u>	<u>90</u>	<u>130</u>
<u>Blue Clay</u>	<u>130</u>	<u>145</u>
<u>Course Sand</u>	<u>145</u>	<u>168</u>

WELL LOCATION:
 sec 20 T 5 N S R 11 E W
8 miles S. of Saucier
 (distance) (direction) (nearest town)

WELL PURPOSE:
 (home, irrigation, municipal, industrial)

WELL COMPLETION DATA:

(1) diameter (inches) 2"

(2) total depth (feet) 168 feet

(3) static water level (feet) 20' below above top of ground.

(4) casing PVC, 158'
 (material) (depth)
 (size) if telescope see back.

(5) screen 10, 158'
 (length) (depth to top)
2", PVC
 (size) (material)

(6) pump _____ (HP) _____ (yield gpm)
electric
 (type power)

(7) electric log _____ (yes or no)
 (organization running log)

(8) how well bottom plugged, Sand
Shack

CODED

DEPT. OF NATURAL RESOURCES
 BUREAU OF LAND & WATER RESOURCES


AUG 30 1982

DRILLERS REMARKS: Owner
has his own
pump

RECEIVED

If well telescopes please sketch and show depths.

GROUND LEVEL

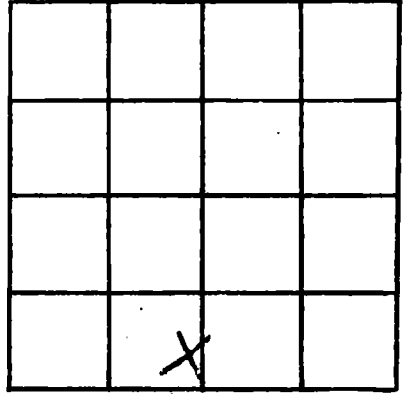

SECTION 20

Please indicate well location X.

ADDITIONAL INFORMATION

If more than one screen, show locations of each on sketch.