

MISSISSIPPI DEPARTMENT OF NATURAL RESOURCES

Bureau of Land and Water Resources

Southport Mall

P.O. Box 10631

Jackson, Mississippi 39209

WATER WELL DRILLERS LOG

Harrison
C234

CODED

2-25 19 83 Duncan Well Drilling Harrison
 date well completed firm name county well located

LANDOWNER: Kenneth Phel
Rt. 2
Sauvier Mo. 39525
 (mailing address)

description of formations encountered	from	to
<u>white clay</u>	<u>0</u>	<u>80</u>
<u>clay + sand</u>	<u>80</u>	<u>250</u>
<u>blue clay</u>	<u>250</u>	<u>310</u>
<u>course sand</u>	<u>310</u>	<u>336</u>

WELL LOCATION:
 sec. 34 T 5 N R 11 E
5 miles SW of Sauvier
 (distance) (direction) (nearest town)

WELL PURPOSE: Home
 (home, irrigation, municipal, industrial)

WELL COMPLETION DATA:

- (1) diameter (inches) 2"
- (2) total depth (feet) 336'
- (3) static water level (feet) 22' below above top of ground.
- (4) casing pvc, 316'
 (material) (depth)
1" if telescope see back.
 (size)
- (5) screen 10', 316'
 (length) (depth to top)
2" (size) pvc (material)
- (6) pump 1 (HP) 8 (yield gpm)
electric (type power)
- (7) electric log (yes or no)
- (8) how well bottom plugged sand
short

DRILLERS REMARKS:

CODED


MISSISSIPPI DEPARTMENT OF NATURAL RESOURCES
 BUREAU OF LAND & WATER RESOURCES

AUG 12 1983

RECEIVED

If well telescopes please sketch and show depths.

GROUND LEVEL

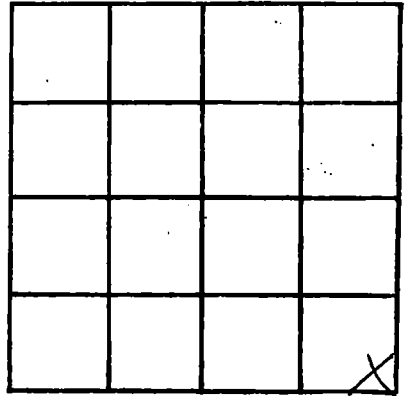

SECTION 24

Please Indicate well location X.

ADDITIONAL INFORMATION

If more than one screen,
show locations of each on sketch.