

Harrison  
C 235

MISSISSIPPI  
 BOARD OF WATER COMMISSIONERS  
 416 North State Street  
 Jackson, Mississippi 39201

CODED

WATER WELL DRILLERS LOG

6-17-83

19 R.V. Mock Driller

HARRISON county well located

date well completed

firm name

county well located

LANDOWNER: HARLIN FOLE

description of formations encountered

from to

NOBLES RD

SAUCKER MS

(mailing address)

TOP SOIL & CLAY

0 130

RED SAND

130 145

BLUE CLAY

145 200

FINE SAND

200 210

MED SAND

210 220

CORRE SAND

220 230

WELL LOCATION:

sec 2 T 5 N R 11 E

1 1/2 miles S of SAUCKER  
 (distance) (direction) (nearest town)

WELL PURPOSE: HOUSE TRAILER  
 (home, irrigation, municipal, industrial)

WELL COMPLETION DATA:

- (1) diameter (inches) 2"
- (2) total depth (feet) 230'
- (3) static water level (feet) 60' below  
 top of ground.
- (4) casing PVC, 220'  
 (material) (depth)  
 (size) if telescope see back.
- (5) screen 10', 220'  
 (length) (depth to top)  
2", PVC  
 (size) (material)
- (6) pump 1, 8  
 (HP) (yield gpm)  
E  
 (type power)
- (7) electric log                       
 (yes or no)  
                      
 (organization running log)

(8) how well bottom plugged                       
S.S.

DRILLERS REMARKS:

CODED


DEPT. OF NATURAL RESOURCES  
 BUREAU OF LAND & WATER RESOURCES

JUL 8 1983

RECEIVED

If well telescopes please sketch and show depths.

GROUND LEVEL

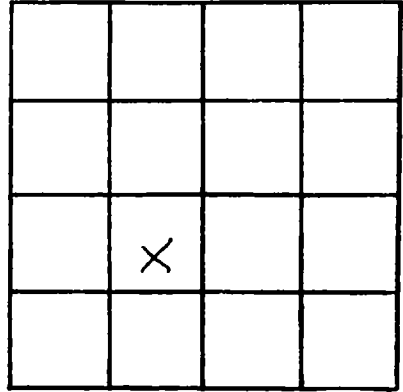

SECTION \_\_\_\_\_

Please indicate well location X.

ADDITIONAL INFORMATION

If more than one screen, show locations of each on sketch.