

MISSISSIPPI DEPARTMENT OF NATURAL RESOURCES

Bureau of Land and Water Resources

Southport Mall

P.O. Box 10631

Jackson, Mississippi 39209 CODED

WATER WELL DRILLERS LOG

Harrison  
C237

July 20 1983 Muncie Well Drilling Harrison  
date well completed firm name county well located

LANDOWNER: Center Howell Jr  
P.O. Box 3133  
Hulport Ms. 39501  
(mailing address)

description of formations encountered	from	to
Clay	0	20
Sand	20	35
Blue Clay	35	160
Course Sand	160	175

WELL LOCATION:  
sec 33 T 5 N R 11 E  
6 miles SE of Saucier  
(distance) (direction) (nearest town)

WELL PURPOSE: Trailer  
(home, irrigation, municipal, industrial)

WELL COMPLETION DATA:

- (1) diameter (inches) 2"
- (2) total depth (feet) 175 ft.
- (3) static water level (feet) 30' below above top of ground.
- (4) casing PVC, 165,  
(material) (depth)  
— if telescope see back.  
(size)
- (5) screen 10', 165  
(length) (depth to top)  
2", PVC  
(size) (material)
- (6) pump 1 8  
(HP) (yield gpm)  
electric  
(type power)
- (7) electric log —  
(yes or no)  
—  
(organization running log)
- (8) how well bottom plugged Sand  
Shank

CODED

DEPT. OF NATURAL RESOURCES  
BUREAU OF LAND & WATER RESOURCES


AUG 15 1983

RECEIVED

DRILLERS REMARKS:

If well telescopes please sketch and show depths.

GROUND LEVEL

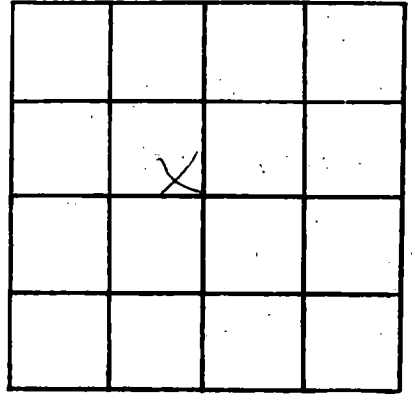

SECTION 33

Please indicate well location X.

ADDITIONAL INFORMATION

Lined area for additional information.

If more than one screen, show locations of each on sketch.