

MISSISSIPPI DEPARTMENT OF NATURAL RESOURCES

Bureau of Land and Water Resources

Southport Mall

P.O. Box 10631

Jackson, Mississippi 39209

WATER WELL DRILLERS LOG

CODED

Harrison
C238

4/13/83 19
 date well completed


Lyman Well
 firm name

Harrison
 county well located

LANDOWNER:	description of formations encountered	from	to
<u>Elizabeth Broadus</u>			
<u>Saucier 39574</u> (mailing address)	<u>Red sand & Gravel</u>	<u>0</u>	<u>84</u>
WELL LOCATION:			
sec. <u>20</u> T <u>5</u> N R <u>11</u> E <u>8</u> miles <u>SE</u> of <u>Saucier</u> (distance) (direction) (nearest town)	CODED		
WELL PURPOSE:			
<u>Home</u> (home, irrigation, municipal, industrial)			
WELL COMPLETION DATA:			
(1) diameter (inches) <u>4"</u>			
(2) total depth (feet) <u>84'</u>			
(3) static water level (feet) <u>30</u> below above top of ground.			
(4) casing <u>PVC</u> , <u>74'</u> (material) (depth) <u>4"</u> (size) if telescope see back.			
(5) screen <u>10'</u> , <u>74'</u> (length) (depth to top) <u>4"</u> , <u>PVC</u> (size) (material)	BUREAU OF NATURAL RESOURCES BUREAU OF LAND & WATER RESOURCES		
(6) pump <u>1</u> , <u>34</u> (HP) (yield gpm) <u>Elect.</u> (type power)	AUG 29 1983		
(7) electric log <u>No</u> (yes or no) <u>NO</u> (organization running log)	RECEIVED		
(8) how well bottom plugged <u>sand</u> <u>shark</u>			
DRILLERS REMARKS:			

If well telescopes please sketch and show depths.

GROUND LEVEL

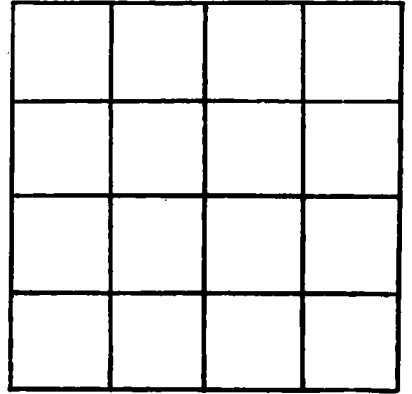

SECTION _____

Please indicate well location X.

ADDITIONAL INFORMATION

If more than one screen, show locations of each on sketch.