

MISSISSIPPI DEPARTMENT OF NATURAL RESOURCES

Bureau of Land and Water Resources

Southport Mall

P.O. Box 10631

Jackson, Mississippi 39209

WATER WELL DRILLERS LOG

CODED.

Harrison  
C 239

4/28/83 19  
date well completed

Syman Well  
firm name

Harrison  
county well located

LANDOWNER: Thomas Papanic  
Rt. 3, Box 131-A  
Gulfport 39503  
(mailing address)

Description of formations encountered	from	to
<u>Red sand gravel &amp; white clay</u>	<u>0</u>	<u>130</u>
<u>Blue clay</u>	<u>130</u>	<u>194</u>
<u>Wood sand</u>	<u>194</u>	<u>234</u>

WELL LOCATION:  
sec. 19 T. 45 N. R. 11 E.  
10 miles N of Port  
(distance) (direction) (nearest town)

WELL PURPOSE: home  
(home, irrigation, municipal, industrial)

WELL COMPLETION DATA:

(1) diameter (inches) 2"

(2) total depth (feet) 234'

(3) static water level (feet) 54 below above top of ground.

(4) casing PVC, 224'  
(material) (depth)

2" if telescope see back.  
(size)

(5) screen 10', 224'  
(length) (depth to top)

2", PVC  
(size) (material)

(6) pump 1, 12  
(HP) (yield gpm)

electric  
(type power)

(7) electric log NO  
(yes or no)

NO  
(organization running log)

(8) how well bottom plugged sand shark

CODED

DEPT. OF NATURAL RESOURCES  
BUREAU OF LAND & WATER RESOURCES


AUG 29 1983

RECEIVED

DRILLERS REMARKS:

If well telescopes please sketch and show depths.

GROUND LEVEL

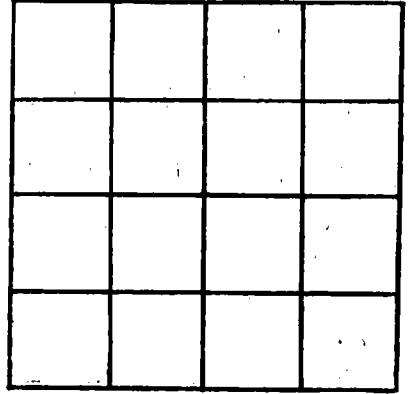

SECTION \_\_\_\_\_

Please indicate well location X.

ADDITIONAL INFORMATION

If more than one screen, show locations of each on sketch.