

MISSISSIPPI DEPARTMENT OF NATURAL RESOURCES

Bureau of Land and Water Resources

Southport Mall

P.O. Box 10631

Jackson, Mississippi 39209

WATER WELL DRILLERS LOG

HARRISON
C 245
2-20-84

CODED

2/20 1984 Braden Pumpwell Harrison
date well completed firm name county well located

LANDOWNER: Myrtle Eaton
Ivan Rd
Saucier, Ms. 39574
(mailing address)

description of formations encountered	from	to
sand + red clay sand	0	70
	70	84

WELL LOCATION:
sec. 21 T. 5 S R. 11 E
10 miles West of Saucier
(distance) (direction) (nearest town)

WELL PURPOSE: Home
(home, irrigation, municipal, industrial)

WELL COMPLETION DATA:

(1) diameter (inches) 2"

(2) total depth (feet) 84'

(3) static water level (feet) 58 below top of ground

(4) casing PVC, 74' (material) (depth)
2" (size) If telescope see back.

(5) screen 10' 74' (length) (depth to top)
2" PVC underbar (size) (material)

(6) pump 1 HP 5 gpm (type) (power) (yield) (gpm)
230V (type power)

(7) electric log no (yes or no)

(organization running log)

(8) how well bottom plugged PVC sand shark

DRILLERS REMARKS: no
tailpipe


DEPT. OF NATURAL RESOURCES
BUREAU OF LAND & WATER RESOURCES

FEB 27 1984

RECEIVED

If well telescopes please sketch and show depths.

GROUND LEVEL

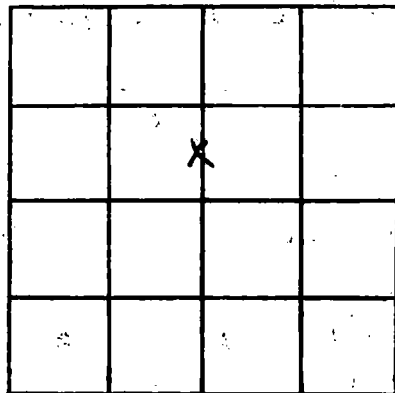

SECTION 21

Please indicate well location X.

ADDITIONAL INFORMATION

If more than one screen, show locations of each on sketch.