

MISSISSIPPI DEPARTMENT OF NATURAL RESOURCES

Bureau of Land and Water Resources

Southport Mall

P.O. Box 10631

Jackson, Mississippi 39209

WATER WELL DRILLERS LOG

HARRISON
C 246
2-20-84

CODED

1984 Braden Pump & Well Dr., Inc. Harrison
 date well completed firm name county well located

LANDOWNER: W. J. Robinson
Rt. 2, Box 82-L3
Saucier, Ms. 39574
 (mailing address)

description of formations encountered	from	to
<u>red clay</u>	<u>0</u>	<u>78</u>
<u>brown sand</u>	<u>78</u>	<u>94</u>

WELL LOCATION:
 sec 21 T 5 S R 11
10 miles West of Saucier
 (distance) (direction) (nearest town)

WELL PURPOSE: home
 (home, irrigation, municipal, industrial)

WELL COMPLETION DATA:

- (1) diameter (inches) 2"
- (2) total depth (feet) 94
- (3) static water level (feet) 44 below above top of ground.
- (4) casing PVC, 84'
 (material) (depth)
- 2"
 (size) if telescope see back.
- (5) screen 10', 84'
 (length) (depth to top)
- 2", PVC underbor
 (size) (material)
- (6) pump — —
 (HP) (yield gpm)
- (type power)
- (7) electric log no
 (yes or no)
- (organization running log)
- (8) how well bottom plugged PVC
sand barbed

DRILLERS REMARKS: NO
tailpipe


DEPT. OF NATURAL RESOURCES
 BUREAU OF LAND & WATER RESOURCES

FEB 27 1984

RECEIVED

If well telescopes please sketch and show depths.

GROUND LEVEL

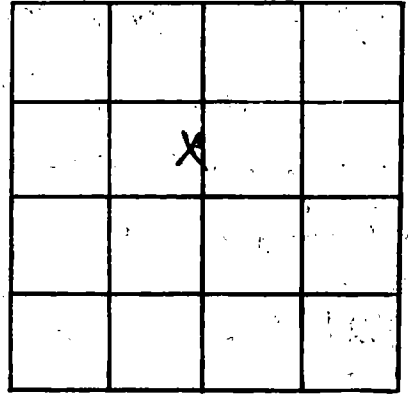

SECTION 21

Please indicate well location X.

ADDITIONAL INFORMATION

If more than one screen, show locations of each on sketch.