

HARRISON
C247
11-2-83

MISSISSIPPI DEPARTMENT OF NATURAL RESOURCES
 Bureau of Land and Water Resources
 Southport Mall
 P.O. Box 10631
 Jackson, Mississippi 39209
WATER WELL DRILLERS LOG

CODED

Nov 2 1983 Duncan Well Drilling Harrison
 date well completed firm name county well located

LANDOWNER: Kinda Osborn
Rt. 3 Box 430 I
Saucler, miss 39574
 (mailing address)

description of formations encountered	from	to
<u>Top sand</u>	<u>0</u>	<u>20</u>
<u>Sand & clay</u>	<u>20</u>	<u>80</u>
<u>Blue clay</u>	<u>80</u>	<u>140</u>
<u>course sand</u>	<u>140</u>	<u>160</u>

WELL LOCATION:
 sec. 20 T 5 N R 11 E
 (S) (W)
10 miles S of Saucler
 (distance) (direction) (nearest town)

WELL PURPOSE:
 (home, irrigation, municipal, industrial)

- WELL COMPLETION DATA:
- diameter (inches) 2"
 - total depth (feet) 160'
 - static water level (feet) 23 below / above top of ground.
 - casing PVC, 150'
 (material) (depth)
 if telescope see back.
 (size)
 - screen 10', 150'
 (length) (depth to top)
2", PVC
 (size) (material)
 - pump HP (type power) (yield gpm)
 - electric log (yes or no)
 (organization running log)
 - how well bottom plugged sand
blank

DRILLERS REMARKS: Owners had their own pump


DEPT. OF NATURAL RESOURCES
 BUREAU OF LAND & WATER RESOURCES

FEB - 8 1984

RECEIVED

If well telescopes please sketch and show depths.

GROUND LEVEL

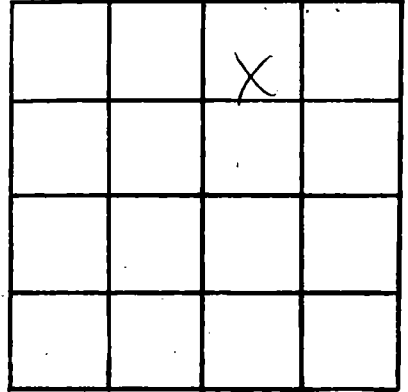

SECTION 20

Please indicate well location X.

ADDITIONAL INFORMATION

If more than one screen, show locations of each on sketch.