

MISSISSIPPI DEPARTMENT OF NATURAL RESOURCES

Bureau of Land and Water Resources

Southport Mall

P.O. Box 10631

CODED

Jackson, Mississippi 39209

WATER WELL DRILLERS LOG

HARRISON  
C 250  
10-18-83

Oct. 18 1983 Duncan Well Drilling Harrison  
 date well completed firm name county well located

LANDOWNER: Don Noble  
P.O. Box 2487  
Southport Ms. 39503  
 (mailing address)

description of formations encountered	from	to
<u>Top Sand</u>	<u>0</u>	<u>25</u>
<u>Sand &amp; Clay</u>	<u>2.5</u>	<u>75</u>
<u>Blue Clay</u>	<u>75</u>	<u>100</u>
<u>Course Sand</u>	<u>100</u>	<u>147</u>

WELL LOCATION:  
 sec 20 T 5 N R 11 E  
1/2 miles S. of Saucier  
 (distance) (direction) (nearest town)

WELL PURPOSE: House  
 (home, irrigation, municipal, industrial)

WELL COMPLETION DATA:

(1) diameter (inches) 2"

(2) total depth (feet) 147

(3) static water level (feet) 22' below above top of ground.

(4) casing PVC, 137'  
 (material) (depth)  
 \_\_\_\_\_ if telescope see back.  
 (size)

(5) screen 10', 137'  
 (length) (depth to top)  
2" \_\_\_\_\_  
 (size) (material)

(6) pump \_\_\_\_\_  
 (HP) (yield gpm)  
 \_\_\_\_\_  
 (type power)

(7) electric log \_\_\_\_\_  
 (yes or no)  
 \_\_\_\_\_  
 (organization running log)

(8) how well bottom plugged sand  
shales

DRILLERS REMARKS: Owner  
Had his own pump


MISSISSIPPI DEPARTMENT OF NATURAL RESOURCES  
 BUREAU OF LAND & WATER RESOURCES

FEB - 8 1984

RECEIVED

If well telescopes please sketch and show depths.

GROUND LEVEL

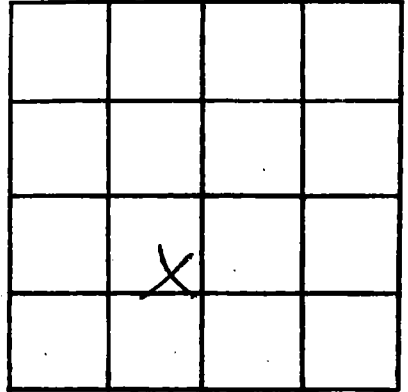

SECTION 20

Please indicate well location X.

ADDITIONAL INFORMATION

If more than one screen, show locations of each on sketch.