

MISSISSIPPI DEPARTMENT OF NATURAL RESOURCES

Bureau of Land and Water Resources

Southport Mall

P.O. Box 10631

Jackson, Mississippi 39209

WATER WELL DRILLERS LOG

CODED

Harrison
252
6-14-83

6/14 1983 Reynolds Well Co. Harrison
 date well completed firm name county well located


LANDOWNER:	description of formations encountered	from	to
<u>David Belton</u> <u>Rt. 2 Box 99</u> <u>Sauces</u> (mailing address) <u>39574</u>	<u>Sand & Gravel</u>	<u>0</u>	<u>60</u>
WELL LOCATION: sec. <u>17</u> T. <u>5</u> N. R. <u>11</u> E. <u>8</u> miles <u>S</u> of <u>Sauces</u> (distance) (direction) (nearest town)			
WELL PURPOSE: <u>Home</u> (home, irrigation, municipal, industrial)			
WELL COMPLETION DATA: (1) diameter (inches) <u>2"</u> (2) total depth (feet) <u>60'</u> (3) static water level (feet) <u>30'</u> <u>below</u> above top of ground. (4) casing <u>2" PVC</u> , <u>50'</u> (material) (depth) <u>2"</u> if telescope see back. (size) (5) screen <u>10'</u> , <u>60'</u> (length) (depth to top) <u>2"</u> , <u>PVC</u> (size) (material) (6) pump <u>1</u> <u>12</u> (HP) (yield gpm) <u>Elec.</u> (type power) (7) electric log <u>NO</u> (yes or no) <u>NO</u> (organization running log) <u>Sand</u> (8) how well bottom plugged <u>shut</u>			
DRILLERS REMARKS:			

DEPT. OF NATURAL RESOURCES
 BUREAU OF LAND & WATER RESOURCES

NOV - 3 1983
RECEIVED

If well telescopes please sketch and show depths.

GROUND LEVEL

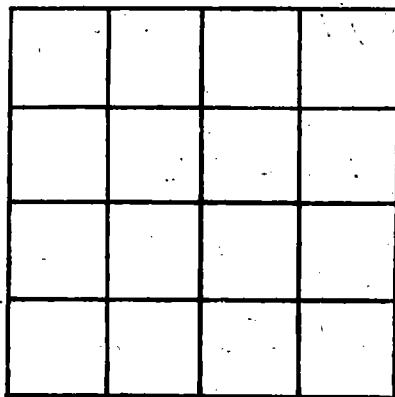

SECTION _____

Please indicate well location X.

ADDITIONAL INFORMATION

If more than one screen,
show locations of each on sketch.