

MISSISSIPPI DEPARTMENT OF NATURAL RESOURCES

Bureau of Land and Water Resources

Southport Mall

P.O. Box 10631

Jackson, Mississippi 39209

WATER WELL DRILLERS LOG

HARRISON
C 253
9-20-83

CODED

Sept. 20 1983 Muncie Well Drilling Harrison
 date well completed firm name county well located

LANDOWNER: Alan Parker
Rt. 1 Box 538
Saucier, Ms. 39574
 (mailing address)

| description of formations encountered | from | to |
|---------------------------------------|------------|------------|
| <u>Clay</u> | <u>0</u> | <u>30</u> |
| <u>fine sand</u> | <u>30</u> | <u>70</u> |
| <u>Blue Clay</u> | <u>70</u> | <u>220</u> |
| <u>Coarse Sand</u> | <u>220</u> | <u>245</u> |

WELL LOCATION:
 sec 21 T S N R 11 E W
5 miles S.E. of Saucier
 (distance) (direction) (nearest town)

WELL PURPOSE: Home
 (home, irrigation, municipal, industrial)

WELL COMPLETION DATA:
 (1) diameter (inches) 2"
 (2) total depth (feet) 245'
 (3) static water level (feet) 25' below above top of ground
 (4) casing PVC, 235'
 (material) (depth)
 (size) if telescope see back.
 (5) screen 10', 235'
 (length) (depth to top)
2", PVC
 (size) (material)
 (6) pump 1, 8
 (HP) (yield gpm)
electric
 (type power)
 (7) electric log _____
 (yes or no)

 (organization running log)

(8) how well bottom plugged Sand
Shark

DRILLERS REMARKS:


MISSISSIPPI DEPARTMENT OF NATURAL RESOURCES
 BUREAU OF LAND AND WATER RESOURCES

FEB 10 1984

RECEIVED

If well telescopes please sketch and show depths.

GROUND LEVEL

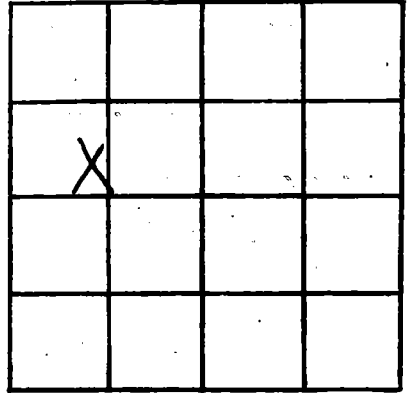

SECTION 21

Please indicate well location X.

ADDITIONAL INFORMATION

If more than one screen,
show locations of each on sketch.