

HARRISON

MISSISSIPPI BOARD OF WATER COMMISSIONERS  
416 North State Street  
Jackson, Mississippi 39201

CODED

LC254

WATER WELL DRILLERS LOG

5-2-80  
5/2/80

19 Lyman Well Co.

Harrison  
county well located

LANDOWNER: M. Barton

description of formations encountered


from

to

Fairley Rd  
Saucier, MS 39574  
(mailing address)

yellow sandy clay 0 12  
Red clay 12 18  
Blue clay 18 190  
S. Red gy. s. 190 225

WELL LOCATION:

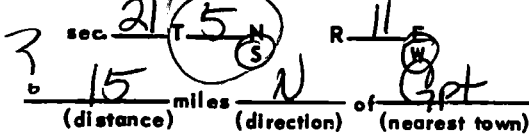

WELL PURPOSE: Home  
(home, irrigation, municipal, industrial)

WELL COMPLETION DATA:

- (1) diameter (inches) 2
- (2) total depth (feet) 225
- (3) static water level (feet) 30 <sup>below</sup> ~~above~~ top of ground.
- (4) casing PVC, 215'  
(material) (depth)  
2in (size) If telescope see back.
- (5) screen 10' 215'  
(length) (depth to top)  
2" 8 slot PVC  
(size) (material)
- (6) pump 1 12  
(HP) (yield gpm)  
etc  
(type power)
- (7) electric log NO  
(yes or no)  
No  
(organization running log)
- (8) how well bottom plugged sand  
shark

CODED

DEPT. OF NATURAL RESOURCES  
BUREAU OF LAND & WATER RESOURCES

JUN 26 1980

RECEIVED

DRILLERS REMARKS:

