

MISSISSIPPI DEPARTMENT OF NATURAL RESOURCES

Bureau of Land and Water Resources

Southport Mall

P.O. Box 10631

Jackson, Mississippi 39209

WATER WELL DRILLERS LOG

HARRISON  
 866-255  
 11/24/80

11/24/80 date well completed  
 1706.24 1980 Suncoast Well Drilling firm name  
 Harrison county well located

LANDOWNER: Theodore Auler  
 901-43 Ave  
 Gulfport, Ms. 39501  
 (mailing address)

description of formations encountered	from to	
	ft	ft
White Clay	0	50
Blue Clay	50	130
Course Sand	130	142

WELL LOCATION:  
 sec 16 T 5 N R 12 E  
 10 miles S.W. of Saucier  
 (distance) (direction) (nearest town)

WELL PURPOSE: Home  
 (home, irrigation, municipal, industrial)

- WELL COMPLETION DATA:
- (1) diameter (inches) 4"
  - (2) total depth (feet) 147.4'
  - (3) static water level (feet) 50' below top of ground
  - (4) casing PVC 137' (material) (depth)
  - (size) if telescope see back.
  - (5) screen 10' 137' (length) (depth to top)
  - 4" PVC (size) (material)
  - (6) pump 20 (HP) (yield gpm)
  - electric (type power)
  - (7) electric log (yes or no)

(organization running log)  
 (8) how well bottom plugged Sand  
 Mark

DRILLERS REMARKS:


DEPT. OF NATURAL RESOURCES  
 BUREAU OF LAND & WATER RESOURCES

MAR 18 1981

**RECEIVED**

If well telescopes please sketch and show depths.

GROUND LEVEL

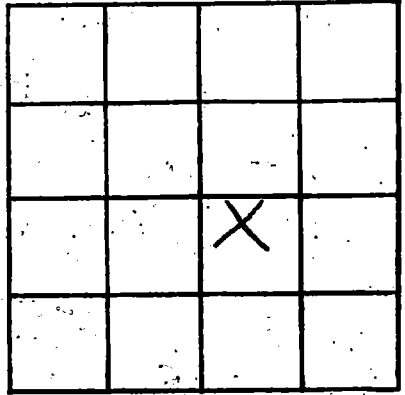

SECTION 16

Please indicate well location X.

ADDITIONAL INFORMATION

If more than one screen, show locations of each on sketch.