

MISSISSIPPI DEPARTMENT OF NATURAL RESOURCES

Bureau of Land and Water Resources

Southport Mall

P.O. Box 10631

Jackson, Mississippi 39209

WATER WELL DRILLERS LOG

C257
HARRISON
1-21-83

CODED

1/21/83 19 Lyman Well Co. Harrison
date well completed firm name county well located

LANDOWNER: Robert White
Rt. 2, Box 82-T3
Saucier 39574
(mailing address)

description of formations encountered	from to	
Red & White Clay	6	20
Red Sand & Gravel	20	61

WELL LOCATION:
sec. 21 T. 5 N. R. 11 E.
6 miles SE of Saucier
(distance) (direction) (nearest town)

WELL PURPOSE: Home
(home, irrigation, municipal, industrial)

- WELL COMPLETION DATA:
- (1) diameter (inches) 2"
 - (2) total depth (feet) 61'
 - (3) static water level (feet) 22' below top of ground
 - (4) casing PVC, 51' (material), (depth)
2" (size) If telescope see back.
 - (5) screen 10', 51' (length), (depth to top)
2" (size), PVC (material)
 - (6) pump 1 (HP), 12 (yield gpm)
electric (type power)
 - (7) electric log No (yes or no)
No (organization running log)
 - (8) how well bottom plugged sand
shark

DEPT. OF NATURAL RESOURCES
BUREAU OF LAND & WATER RESOURCES


MAY 11 1984

RECEIVED

DRILLERS REMARKS:

If well telescopes please sketch and show depths.

GROUND LEVEL

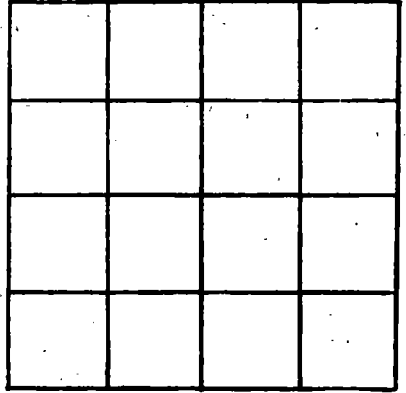

SECTION _____

Please indicate well location X.

ADDITIONAL INFORMATION

If more than one screen, show locations of each on sketch.