

MISSISSIPPI DEPARTMENT OF NATURAL RESOURCES

Bureau of Land and Water Resources

Southport Mall

P.O. Box 10631

Jackson, Mississippi 39209

WATER WELL DRILLERS LOG

CODED

HARRISON  
E 263  
2/22/84

2/22/84 19 Lyman Well Co Harrison  
date well completed firm name county well located

LANDOWNER: Ed Heldt  
Luran Rd.  
Saucier 39574  
(mailing address)

description of formations encountered	from	to
Red Sand & Gravel	0	68

WELL LOCATION:  
sec 28 T. 5 N R. 11 E  
18 miles N/E of GAT.  
(distance) (direction) (nearest town)

CODED

WELL PURPOSE: home  
(home, irrigation, municipal, industrial)

WELL COMPLETION DATA:

(1) diameter (inches) 2"

(2) total depth (feet) 68'

(3) static water level (feet) 35' (below top of ground)

(4) casing PVC, 58' (material) (depth)  
2" (size) If telescope see back.

(5) screen 10' (length), 58' (depth to top)  
2" (size) PVC (material)

(6) pump 1/2 (HP), 15 (yield gpm)  
Elect. (type power)

(7) electric log No (yes or no)  
No (organization running log)

(8) how well bottom plugged sand  
shank

DEPT. OF NATURAL RESOURCES  
BUREAU OF LAND & WATER RESOURCES


SEP - 5 1984

RECEIVED

DRILLERS REMARKS:

If well telescopes please sketch and show depths.

GROUND LEVEL

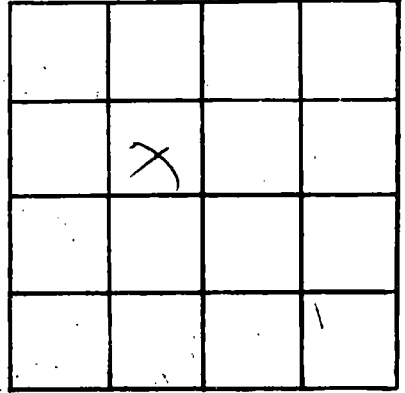

SECTION 21

Please indicate well location X.

ADDITIONAL INFORMATION

If more than one screen, show locations of each on sketch.