

MISSISSIPPI DEPARTMENT OF NATURAL RESOURCES

Bureau of Land and Water Resources

Southport Mall

P.O. Box 10631

Jackson, Mississippi 39209

WATER WELL DRILLERS LOG

CODED

HARRISON
C 265

1/30/84
date well completed

19 Lyman Well Co.
firm name

Harrison
county well located

LANDOWNER: Jim Lafferty

Rt. 2, Box 307 A

Sauvies, MS 39574
(mailing address)

description of formations encountered

from to

<u>Red White Clay</u>	<u>0</u>	<u>80</u>
<u>Blue Clay</u>	<u>80</u>	<u>170</u>
<u>Coarse Sand</u>	<u>170</u>	<u>194</u>

WELL LOCATION:

sec. 33 T. 4 N. R. 11 E
8 miles S/E of Sauvies
 (distance) (direction) (nearest town)

WELL PURPOSE: Home
 (home, irrigation, municipal, industrial)

CODED

WELL COMPLETION DATA:

- (1) diameter (inches) 2"
- (2) total depth (feet) 194'
- (3) static water level (feet) 50' below above top of ground
- (4) casing PVC, 184'
 (material) (depth)
2" if telescope see back.
 (size)
- (5) screen 10', 184'
 (length) (depth to top)
2", PVC
 (size) (material)
- (6) pump 1 12
 (HP) (yield gpm)
Elec.
 (type power)
- (7) electric log No
 (yes or no)
No
 (organization running log)
- (8) how well bottom plugged sand
shark

DEPT. OF NATURAL RESOURCES
 BUREAU OF LAND & WATER RESOURCES


SEP - 5 1984

DRILLERS REMARKS:

RECEIVED

If well telescopes please sketch and show depths.

GROUND LEVEL

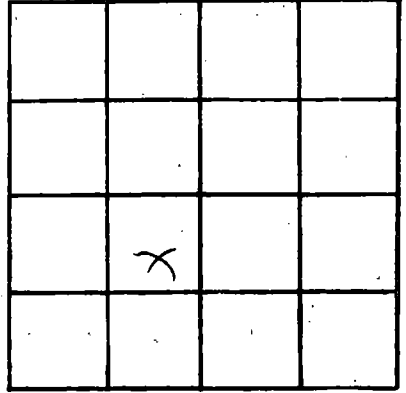

SECTION 33

Please indicate well location X.

ADDITIONAL INFORMATION

If more than one screen, show locations of each on sketch.