

MISSISSIPPI DEPARTMENT OF NATURAL RESOURCES

Bureau of Land and Water Resources

Southport Mall

P.O. Box 10631

Jackson, Mississippi 39209

WATER WELL DRILLERS LOG

CODED

HARRISON  
C 270

10-5-84  
date well completed

BRADEN Pump + Well

HARRISON

SERVICE, INC.  
firm name

county well located

LANDOWNER: Harold Blackwell

description of formations encountered

from

to

Rt 2 Box 39

Saucier, Ms. 39574

(mailing address)

CLAY

0

40

SAND

40

80

CLAY

80

200

CLAY + SAND

200

240

SAND

240

320

CLAY + SAND

320

340

WELL LOCATION:

sec 20 T 5 S R 11 E  
5 miles SE of Saucier  
(distance) (direction) (nearest town)

WELL PURPOSE: HOME  
(home, irrigation, municipal, industrial)

WELL COMPLETION DATA:

(1) diameter (inches) 4x2"

CODED

(2) total depth (feet) 340

(3) static water level (feet) 75 below top of ground

(4) casing PVC 310  
(material) (depth)

4x2 (size) if telescope see back.

(5) screen 10' 310'  
(length) (depth to top)

2" PVC underbar  
(size) (material)

(6) pump 1 25  
(HP) (yield gpm)

230V  
(type power)

(7) electric log No  
(yes or no)

(organization running log)

(8) how well bottom plugged PVC sand/shark

DRILLERS REMARKS: 20 ft tail pipe

DEPT OF NATURAL RESOURCES  
BUREAU OF LAND & WATER RESOURCES

OCT 22 1984

RECEIVED


If well telescopes please sketch and show depths.

GROUND LEVEL

240'  
4" PKC

100'  
2" PKC

20'  
Tie Pipe

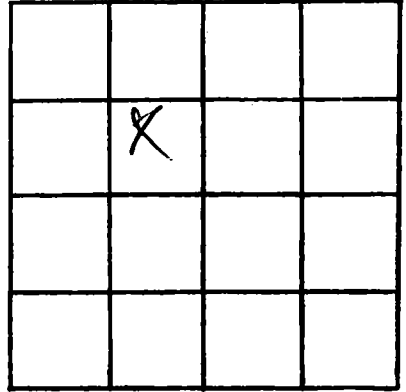

SECTION 20

Please indicate well location X.

ADDITIONAL INFORMATION

If more than one screen, show locations of each on sketch.