

MISSISSIPPI DEPARTMENT OF NATURAL RESOURCES
Bureau of Land and Water Resources

Southport Mall

P.O. Box 10631

CODED

Jackson, Mississippi 39209

WATER WELL DRILLERS LOG

C 275
Harrison
11-6-84

11-6 1984 Frank Piper Harrison
date well completed firm name county well located

LANDOWNER:	description of formations encountered	from	to
Dewey Smith	Top Soil	0	2
(mailing address)	Sandy clay	2	15
WELL LOCATION:	Fin. Sand	15	90
sec. 14 T. 5 S. R. 11 W.	Coarse Sand	90	100
1 miles N of SUCCESS			
(distance) (direction) (nearest town)			
WELL PURPOSE: HOME			
(home, irrigation, municipal, industrial)			
WELL COMPLETION DATA:			
(1) diameter (inches) 2"			
(2) total depth (feet) 100'			
(3) static water level (feet) 60' below top of ground.			
(4) casing PVC 95'			
(material) (depth)			
(size) If telescope see back.			
(5) screen 5' 95'			
(length) (depth to top)			
2" PVC			
(size) (material)			
(6) pump 1 9			
(HP) (yield gpm)			
Elect			
(type power)			
(7) electric log NO			
(yes or no)			
(organization running log)			
(8) how well bottom plugged			
BWV			
DRILLERS REMARKS:			


DEPT. OF NATURAL RESOURCES
BUREAU OF LAND & WATER RESOURCES

DEC - 7 1984

RECEIVED

If well telescopes please sketch and show depths.

GROUND LEVEL

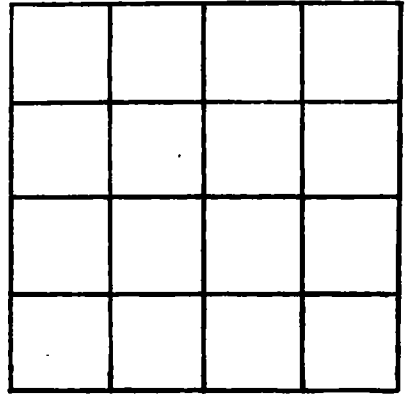

SECTION _____

Please indicate well location X.

ADDITIONAL INFORMATION

If more than one screen,
show locations of each on sketch.