

MISSISSIPPI DEPARTMENT OF NATURAL RESOURCES

Bureau of Land and Water Resources

Southport Mall

P.O. Box 10631

Jackson, Mississippi 39209

CODED

WATER WELL DRILLERS LOG

C 276
Harrison
8-8-84

9/2/84 19 Lipman Well Co. Harrison
date well completed firm name county well located

LANDOWNER: Russell Lisdale
Rt. 2, Twan Rd.
Saucier, Md 39574
(mailing address)

| description of formations encountered | from | to |
|---------------------------------------|------------|------------|
| <u>red clay</u> | <u>0</u> | <u>10</u> |
| <u>red sand gravel</u> | <u>11</u> | <u>70</u> |
| <u>yellow clay</u> | <u>71</u> | <u>170</u> |
| <u>yellow sand</u> | <u>171</u> | <u>204</u> |

WELL LOCATION:
sec. 22 T. S N. R. 11 E.
6 miles S of Saucier
(distance) (direction) (nearest town)

WELL PURPOSE: Home
(home, irrigation, municipal, industrial)

WELL COMPLETION DATA:

(1) diameter (inches) 4"

(2) total depth (feet) 204'

(3) static water level (feet) 70' below above
top of ground.

(4) casing PVC 194'
(material) (depth)
4"
(size) If telescope see back.

(5) screen 10' 194'
(length) (depth to top)
4" PVC
(size) (material)

(6) pump 1 25
(HP) (yield gpm)
electric
(type power)

(7) electric log No
(yes or no)
No
(organization running log)


(8) how well bottom plugged sand
Shark

DRILLERS REMARKS:

DEPT. OF NATURAL RESOURCES
BUREAU OF LAND & WATER RESOURCES
RECEIVED
DEC 10 1984

If well telescopes please sketch and show depths.

GROUND LEVEL

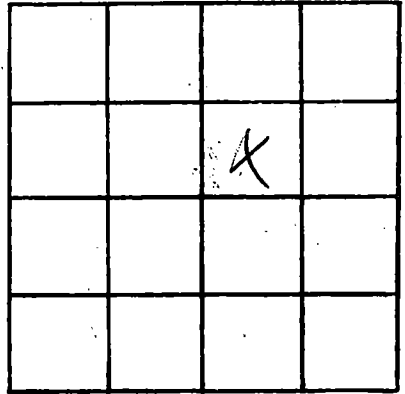

SECTION 22

Please indicate well location X.

ADDITIONAL INFORMATION

If more than one screen, show locations of each on sketch.