

MISSISSIPPI DEPARTMENT OF NATURAL RESOURCES

Bureau of Land and Water Resources

Southport Mall

P.O. Box 10631

Jackson, Mississippi 39209

WATER WELL DRILLERS LOG

CODED

C 277
Harrison
11-7-84

11/7/84 19
date well completed

Lyman Well Co
firm name

Harrison
county well located

LANDOWNER: Shep Patton
Rt. 3, Box 609-A
Gulfport, Ms 39503
(mailing address)

description of formations encountered	from	to
<u>sandy mud</u>	<u>0</u>	<u>20</u>
<u>sand</u>	<u>20</u>	<u>70</u>

WELL LOCATION:

sec 23 T 5 N R 11 E
15 miles NW of Gpt
(distance) (direction) (nearest town)

CODED

WELL PURPOSE: home
(home, irrigation, municipal, industrial)

WELL COMPLETION DATA:

- (1) diameter (inches) 3 1/2"
- (2) total depth (feet) 70'
- (3) static water level (feet) 17' below above top of ground.
- (4) casing PVC, 50'
(material) (depth)
2" if telescope see back.
(size)
- (5) screen 20', 50'
(length) (depth to top)
2", PVC
(size) (material)
- (6) pump 1 (HP), 11 (yield gpm)
electric
(type power)
- (7) electric log No (yes or no)
NO
(organization running log)
- (8) how well bottom plugged sand
shark

DRILLERS REMARKS:


DEPT. OF NATURAL RESOURCES
BUREAU OF LAND & WATER RESOURCES

DEC 17 1984

RECEIVED

If well telescopes please sketch and show depths.

GROUND LEVEL

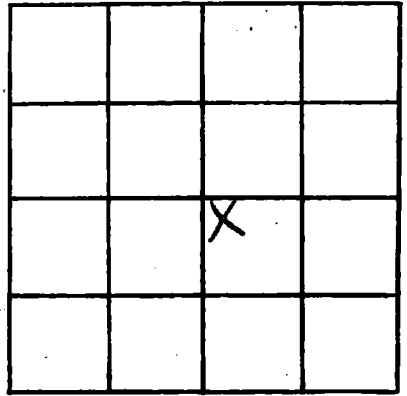

SECTION 23

Please indicate well location X.

ADDITIONAL INFORMATION

If more than one screen,
show locations of each on sketch.