

MISSISSIPPI DEPARTMENT OF NATURAL RESOURCES

Bureau of Land and Water Resources

Southport Mall

P.O. Box 10631

Jackson, Mississippi 39209

WATER WELL DRILLERS LOG

CODED

Harrison
C 285
1/28/85

1/28/85 date well completed 19 Lyman Well Co. firm name Harrison county well located

LANDOWNER: Katherine McBride
Hwy 49
Lancien, Md 39574
(mailing address)

description of formations encountered	from	to
white clay	0	40
blue clay	40	240
blue sand fine	240	250
blue clay	250	300
blue sand coarse	300	350

WELL LOCATION:
sec. 30 T. 5 N. R. 11 E.
5 miles south of Lancien
(distance) (direction) (nearest town)

WELL PURPOSE: HOUSE
(home, irrigation, municipal, industrial)

WELL COMPLETION DATA:

(1) diameter (inches) 2"

(2) total depth (feet) 350'

(3) static water level (feet) 63 below above top of ground.

(4) casing PVC 340'
(material) (depth)
2" (size) if telescope see back.

(5) screen 10' 340'
(length) (depth to top)
2" PVC
(size) (material)

(6) pump 1 12
(HP) (yield gpm)
electric
(type power)

(7) electric log No
(yes or no)
No
(organization running log)

(8) how well bottom plugged Sand
shark

CODED


RECEIVED
MAY 24 1985

Department of Natural Resources
Bureau of Land & Water Resources

DRILLERS REMARKS:

If well telescopes please sketch and show depths.

GROUND LEVEL

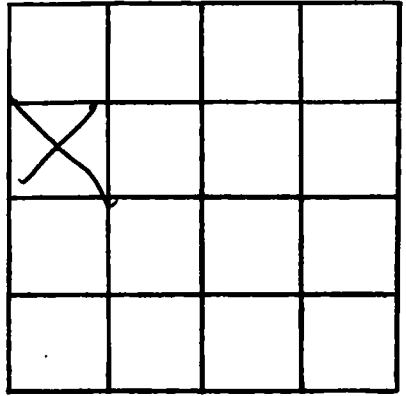

SECTION 80

Please indicate well location X.

ADDITIONAL INFORMATION

A series of 20 horizontal lines for writing additional information.

If more than one screen, show locations of each on sketch.