

MISCELLANEOUS GW DATA

			Date of Measurement	Acuifer Sampled	Temp	Value
R=192	T=A	738#1	1934	1954	196JCC010	1974
			Date of Measurement	Acuifer Sampled	So Cond	Value
R=192	T=A	738#2	1934	1954	196JCC095	1974
			Date of Measurement	Acuifer Sampled	oH	Value
R=192	T=A	738#3	1934	1954	196JCC-00	1974

MISCELLANEOUS LOGS DATA

			Loc Type	Sec. Depth	End Depth
R=198	T=A	739#1	1994	2004	2014
			Loc Type	Sec. Depth	End Depth
R=198	T=A	739#1	1994	2004	2014

MISCELLANEOUS NETWORK DATA $706 \pm QW$ WL, WD, X

			Sec. Year	End Year	Agency Source	Freq.
R=114	T=A	730#1	1154	1164	120A	1174
R=114	T=A	730#2	1154	1164	1174	1184

MISCELLANEOUS REMARKS DATA

			Date of Remarks	Remarks
R=183	T=A	311#1	1844	1854

DISCHARGE DATA


		Date	Type	Discharge	So. Capacity
R=146	T=A	147#1	1484	1504	2724

GEOHYDROLOGIC DATA

		Depth Top	Depth Bot.	Unit Id
R=90	T=A	721#1	914	924

HYDRAULIC DATA

		Unit Tested
R=98	T=A	790#1

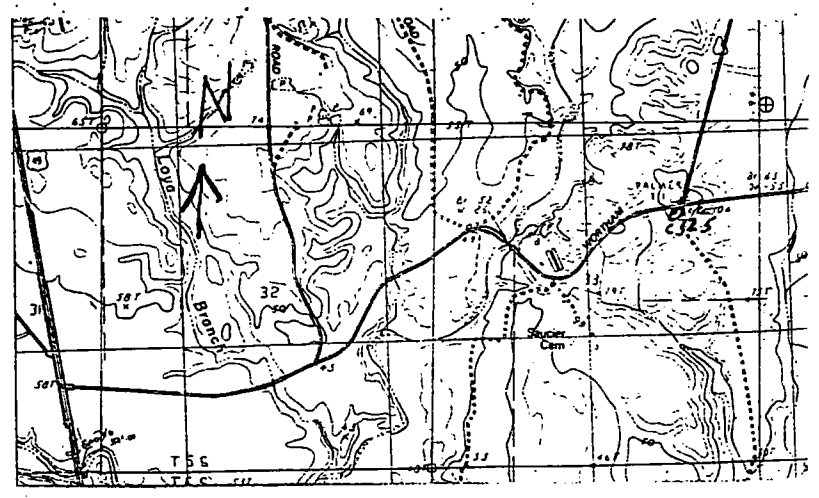

MISSISSIPPI DEPARTMENT OF ENVIRONMENTAL QUALITY
Office of Land and Water Resources

P. O. Box 10631
Jackson, MS 39289-0631
WATER WELL DRILLERS LOG

COUNTY WELL LOCATED
HARRISON

WELL NUMBER **C325** CODED

DATE WELL COMPLETED
10-18-96

PERMIT NUMBER **GW 16151**

NAME OF DRILLING FIRM
LYMAN WELL Co.

NAME & MAILING ADDRESS OF LANDOWNER
Palmer Creek Utilities
15456 SUB LADNER RD
GULFPORT, MS 39503

WELL LOCATION SEC **33** TOWNSHIP **5 N** RANGE **11 E**

DISTANCE _____ DIRECTION _____ NEAREST TOWN _____

OTHER LANDMARK _____

WELL PURPOSE HOME, AGRICULTURE, MUNICIPAL, INDUSTRIAL, FIRE POND, ETC

PUMP DATA

PUMP TYPE (Circle One): Submersible, Turbine, Jet, Flowing Well.
Other (Describe) _____

POWER TYPE (Circle One): Electric, Tractor, Diesel, Gasoline, Butane.
Other (Describe) _____ H/P _____

Pump Capacity (GPM) **550** No of Stages **5** Setting Depth **120** FT.

PUMP TEST

Well yielded **600** GPM with a drawdown of **3'** ft. after **24** hours of pumping

RECEIVED
AUG 16 2000
BY: O.L.P.

WELL DATA

Well Depth **1414** Casing Diameter (in) **10"** Casing Length (ft) **1365**

Type of Casing **steel** Hole Depth **1414** Depth to Static Water Level _____

TYPE OF COMPLETION: (Circle One or More): Gravel Packed, Underreamed, Telescoped, Natural Development, Open Hole, Other (Describe) _____

WELL GROUTED TO A DEPTH OF **1365** FEET
Type Grout (circle one) Cement, Bentonite, or Mix

LOG DATA

TYPE OF LOG RUN (Circle One): No Log Run, Electric, Gamma Ray, Density, Sonic, Neutron, Other (Describe) _____

Name of Organization Running Log
state

SCREEN DATA

Diameter - inches **6"** Length - feet **50** Slot Size - inches **1/2**

Screen Type **stainless steel** Depth to Bottom - feet **1414**

GEOLOGIC DATA (Office Use Only)

Surface Elev	Geologic Unit	Unit Thickness	Depth to Top
Subs. Surf.	Date	Analysis	Aquifer Test

Driller's Remarks: _____

Top of Lap Pipe or Reduction in Casing _____

FEET TELESCOPED OR MORE THAN ONE SCREEN: USE BACK PAGE

DESCRIPTION OF FORMATIONS ENCOUNTERED	FROM	TO	FORMATIONS (Continued)	FROM	TO
Red sand & clay	0	50			
white clay	50	120			
yellow sand	120	134			
blue clay	134	310			
sand	240	324			
blue clay	314	750			
sand fine	350	770			
blue clay	770	1365			
sand	1365	1420			

IF MORE SPACE IS NEEDED, USE BACK

Copy

