




If well telescopes please sketch and show depths.

GROUND LEVEL

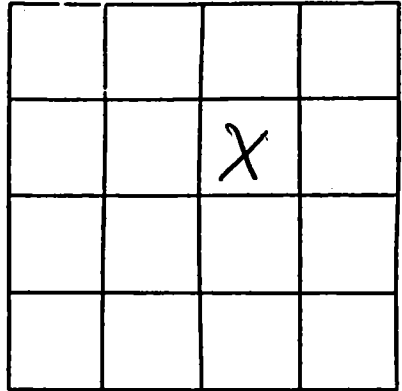

SECTION 30

Please indicate well location X.

Pump Capacity (GPM) <u>14</u>	No. of Stages <u>2</u>	Setting Depth <u>65</u> FT.
----------------------------------	---------------------------	--------------------------------

PUMP TEST

Well yielded 20 GPM with  
a drawdown of \_\_\_\_\_ ft.  
after \_\_\_\_\_ hours of pumping

LOG DATA

TYPE OF LOG RUN (Circle One):      No Log Run.  
Electric, Gamma Ray, Density, Sonic, Neutron.  
Other (Describe) \_\_\_\_\_

Name of Organization Running Log

GEOLOGIC DATA (Office Use Only)

Surface Elev.	Geologic Unit	Unit Thickness	Depth to Top
Subs. SWL	Date	Analysis	Aquifer Test

Driller's Remarks

---



---



If more than one screen, show location of each on sketch.