

MISSISSIPPI DEPARTMENT OF ENVIRONMENTAL QUALITY

Office of Land and Water Resources

P. O. Box 10631
Jackson, MS 39289-0631
WATER WELL DRILLERS LOG

COUNTY WELL LOCATED ADAMS	
WELL NUMBER C-339	CODED
DATE WELL COMPLETED 09-09-03	

PERMIT NUMBER 0239
NAME OF DRILLING FIRM McNeil Pump & Well

NAME & MAILING ADDRESS OF LANDOWNER Pierce Blankenship			
(Jake Bond) Yankee Town Rd.			
Latitude: Saucier, MS			
Longitude:			
WELL LOCATION	SEC	TOWNSHIP	RANGE
	30	5	11
DISTANCE	DIRECTION	NEAREST TOWN	
10 Miles	N	GRPT.	
OTHER LANDMARK OLD HWY. 49			
WELL PURPOSE: <input checked="" type="checkbox"/> Home Irrigation, <input type="checkbox"/> Municipal, <input type="checkbox"/> Industrial, <input type="checkbox"/> Fish Pond, etc.			

PUMP DATA		
PUMP TYPE (Circle One): Submersible, Turbine, <input checked="" type="radio"/> Jet, Flowing Well, Other (Describe) _____		
POWER TYPE (Circle One): <input checked="" type="radio"/> Electric, Tractor, Diesel, Gasoline, Butane, Other (Describe) _____ H/P _____		
DESCRIPTION OF FORMATIONS ENCOUNTERED	FROM	TO
MUD / RED	10	40
MUD / SAND / RED	40	100
MUD / BLUE	100	160
MUD / SAND / BLUE	160	180
SAND / BLUE	180	210
MUD / BLUE	200	220
MUD / SAND / BLUE	220	260
SAND / BLUE	260	300
RECEIVED		
OCT 13 2003		
BY: OLWR		
Top of Lap Pipe or Reduction in Casing		
FEET	IF TELESCOPED OR MORE THAN ONE SCREEN: USE BACK PAGE	

WELL DATA		
Well Depth 300	Casing Diameter (In.) 2" 280	Casing Length (Ft.) 280
Type of Casing PVC	Hole Depth 300	Depth to Static Water Level 80
TYPE OF COMPLETION: (Circle One or More): <input checked="" type="checkbox"/> Gravel Packed, <input type="checkbox"/> Underreamed, <input type="checkbox"/> Telescoped, <input checked="" type="checkbox"/> Natural Development, <input type="checkbox"/> Open Hole, <input type="checkbox"/> Other (Describe) _____		
WELL GROUTED TO A DEPTH OF 10 FEET Type Grout (circle one) <input checked="" type="checkbox"/> Cement, <input type="checkbox"/> Bentonite, or Mix		

SCREEN DATA		
Diameter - Inches 2"	Length - Feet 20'	Slot Size - Inches .0006
Screen Type PVC	Depth to Bottom - Feet 300	

I certify that the well was drilled, constructed and completed in accordance with all applicable Requirements of the Mississippi Department of Environmental Quality and/or the Mississippi Department of Health regulations and state laws.


Michael McNeil 0239
Signature of Licensed Driller and License No.

10/08/03
Date

Additional Information Required On Back

If well telescopes please sketch and show depths.

GROUND LEVEL

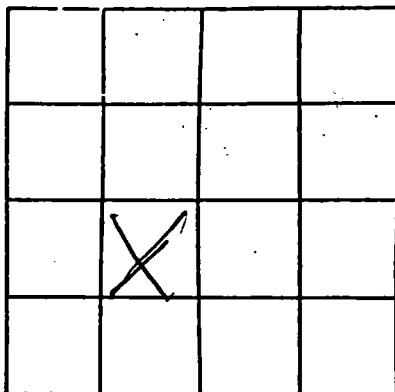

SECTION _____

Please indicate well location X.

Pump Capacity (GPM) <i>12</i>	No. of Stages <i>2</i>	Setting Depth <i>100</i>	FT.
PUMP TEST			
Well yielded <u><i>8</i></u> GPM with a drawdown of <u><i>10</i></u> ft. after <u><i>12</i></u> hours of pumping			

LOG DATA

TYPE OF LOG RUN (Circle One): Electric, Gamma Ray, Density, Sonic, Neutron, Other (Describe) _____	<u>No Log Run</u>
Name of Organization Running Log	

GEOLOGIC DATA (Office Use Only)

Surface Elev.	Geologic Unit	Unit Thickness	Depth to Top
Subs. SWL	Date	Analysis	Aquifer Test

Driller's Remarks

If more than one screen,
show location of each on sketch.