
	Vell Report
County: Harrison Part 1 - 1	Driller's Log For Office Use Only:
Wississippi Departite	nt of Environmental Quality Aquifer: 588
	and Water Resources  Box 10631  Well #:
Driner.	DOX 10051
1. 17	AS 39289-0631 L. S. Elevation:
	961-5210 4-6938 (fax) E-log #:
(001)33	Ling in
State Law requires that this report be prepared by the lic Department at the above address within 30 days of com	ense holder responsible for the work and filed with the pletion of drilling of the well or borehole.
Information on Well Owner	Well or Borehole Location
(Landowner if borehole is not for a water well)	Latitude: 30 38. 820 Longitude: 9 04. 145.
Owner Name Linda Rouse	Latitude: 30 30 1020" Longitude: 47 87.175"
Mailing Address: 13557	Method of Lat/Long (circle one): Conventional Survey,
Joe Bill RA.	USGS quad, Hand-held GPS urvey-grade GPS
	58 14 5 W 14 Sec 34 Twn 45 Rng 11 W
Saucser Ms. 39574 City State Zip Code	3 /4 / Sec 31 1 Wh 4 King 11
City State Zip Code	Distance Direction Nearest Town
Telephone No. (228) 832-7785	Miles of
relephone No. (227) 832-7773	
Well / Bor	chole Data
Date drilling started: 10-12 Date drilling completed: 10-	Hole depth: 268 Hole diameter:
Location of the source of any surface water used for drilling:	
Method of dosing and volume of Chlorine used in drilling and deve	lopment:
Logs run (circle all applicable): No log run Electric Gamma Ray	
Name of organization running log(s):	Density Sonic Neutron Other.
)	
Purpose of borehole (check one): Water Well Geotechnical/Geo	logical Investigation Ground Source Heat Pump
Purpose of borehole (check one): Water WellGeotechnical/Geo	
Purpose of borehole (check one): Water Well Geotechnical/Geo	e)
Purpose of borehole (check one): Water Well Geotechnical/Geo  Seismic Survey Other (describ  If drilling is not related to water well construction	e) on, skip the remainder of this block
Purpose of borehole (check one): Water Well Geotechnical/Geo	e) on, skip the remainder of this block
Purpose of borehole (check one): Water Well Geotechnical/Geo  Seismic Survey Other (describ  If drilling is not related to water well construction	e)
Purpose of borehole (check one): Water Well Geotechnical/Geo  Seismic Survey Other (describ  If drilling is not related to water well construction  Purpose of Well (check one): Home Industrial Public Supplements.	e)
Purpose of borehole (check one): Water Well Geotechnical/Geo  Seismic Survey Other (describ  If drilling is not related to water well construction  Purpose of Well (check one): Home Industrial Public Suppl  If a flowing well, method of flow regulation: Valve (	e)
Purpose of borehole (check one): Water Well Geotechnical/Geo  Seismic Survey Other (describ  If drilling is not related to water well construction  Purpose of Well (check one): Home Industrial Public Suppl  If a flowing well, method of flow regulation: Valve (  Static Water Level: feet above or below circle one)	e)
Purpose of borehole (check one): Water Well Geotechnical/Geo  Seismic Survey Other (describ  If drilling is not related to water well construction  Purpose of Well (check one): Home Industrial Public Suppl  If a flowing well, method of flow regulation: Valve (construction)  Static Water Level: feet above or below circle one)  Method of Measurement (circle one) steel tape electric tape	e)
Purpose of borehole (check one): Water Well Geotechnical/Geo  Seismic Survey Other (describ  If drilling is not related to water well construction  Purpose of Well (check one): Home Industrial Public Suppl  If a flowing well, method of flow regulation: Valve (construction)  Static Water Level: feet above or below circle one)  Method of Measurement (circle one) steel tape electric tape  Well depth: Well grouted to a depth of feet Typ	e)
Purpose of borehole (check one): Water Well Geotechnical/Geo  Seismic Survey Other (describ  If drilling is not related to water well construction  Purpose of Well (check one): Home Industrial Public Suppl  If a flowing well, method of flow regulation: Valve (construction)  Static Water Level: / O feet above or below (circle one)  Method of Measurement (circle one) steel tape electric tape  Well depth: 26 D Well grouted to a depth of / D feet Typ  Casing length: 24 D feet Casing diameter: 3	e)
Purpose of borehole (check one): Water Well Geotechnical/Geo  Seismic Survey Other (describ  If drilling is not related to water well construction  Purpose of Well (check one): Home Industrial Public Suppl  If a flowing well, method of flow regulation: Valve (construction)  Static Water Level: / O feet above or below circle one)  Method of Measurement (circle one) steel tape electric tape  Well depth: 26	e) on, skip the remainder of this block  yIrrigationFish CultureOther: Other (describe)  land surface Date measured:/0~/2~0~9  e air line other: e of grout (circle one): Neat Cement Bentonite Mixinches Type of casing:/VCinches Type of screen:/VC//2 feet to/40

feet. If telescoped or more than one screen, describe on next page

Form: OLWR-SWR-1A

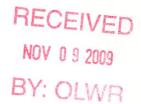


#### The sketch below only required for water wells

## If well telescopes, show depths on sketch. Ground Level.

## <u>Description of formations encountered must be provided for all wells and boreholes, unless specifically exempted by regulations</u>

Description of Formations Encountered	From (depth)	To (depth)
Clay	Ground Level	20
1		
Sand	20	65
Clay	65	170
•		
Sand	170	180
Class	180	235
Sand	235	260
		1
		1

If more than one screen, show location of each on sketch

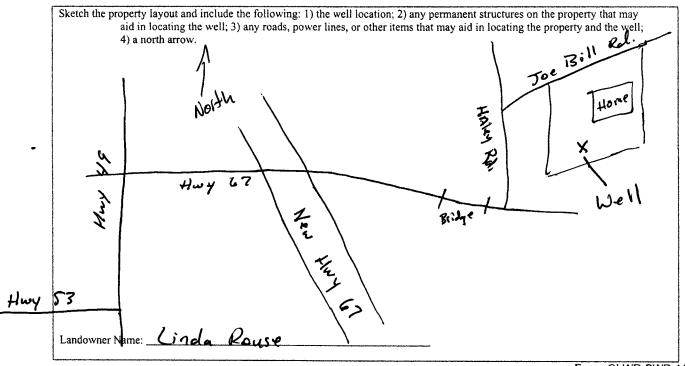

Form: OLWR-SWR-1A

I certify that the well/borehole was drilled, constructed, and completed in accordance with all applicable requirements of the Mississippi Department of Environmental Quality and the Mississippi Department of Health regulations, if applicable, and state

MALUIN WAGNON 0-785 10-12-09

Print Name of Responsible Licensee and License No.

Date

Mat Wagn

Signature of Licensee

2009

### STATE WELL REPORT

# 

## Part 2 Installer's Completion Report

Pump Installer's Completion Report
Mississippi Department of Environmental Quality
Office of Land and Water Resources
P.O. Box 10631
Jackson, MS 39289-0631
(601)961-5210

For Of	ffice Use Only:
Aquifer:	388
Well #:	
Elevation:	

Copy information from block on Part 1	(601)354-6938 (fax) Elevation:
This part of the report must be completed by a licensed wat report must be attached and both parts filed with the Depar	er well contractor or a licensed pump installer. A copy of Part I of the timent at the above address within 30 days of well completion.
Well Owner Information	Well Location
Owner Name: Linda Rouse	Latitude: 30 38.820 Longitude: 89 04.195
Mailing Address: /35-5-7	Method of Lat/Long (check one): Conventional Survey
Joe Bill Rd.	USGS quad, Hand-held GPS, Survey-grade GPS
Saucier Ms. 29574 City State Zip Code	
	Distance Direction Nearest Town
Telephone No. 228 832 - 7785	Miles of
Pump Type	Payer Type
Circle one	Power Type Circle one
Air Lift Jet Submersione	Diesel Engine Gasoline Engine Natural Gas
Bucket Piston Turbine	Electric Motor Hand Tractor PTO
Centrifugal Rotary Flowing Well	Windmill Other (specify):
Other (specify):	Horse Power Rating of Motor:
Date Pump Installed: 10-13-09	Setting Depth: 160 feet
Rated Pump Capacity: 22 Gallons Per Minu	ite Number of Stages:
Pump Test Data	Method of Measuring Water Level
Date Well Tested:	Circle one
Static Water Level (A): 100 Feet Below Land Surf	Air Line Electric Measuring Line Steel Tape
Pumping Water Level (B): 160 Feet Below Land Surfa	Other (specify):
Drawdown [(B) – (A)]: 40 Feet Below Land Surfi	
Test Pumping Rate:Gallons Per Minu	
Duration of Pump Test (minimum 4 hours): 24 hou	The state of the s

HEREBY CERTIFY that the above statements are true	to the hest of my knowledge	4
---	-----------------------------	---

MALVIN WAGNON 0-785
Print Name of Pump Installer and License No. (if applicable)

Met Wagner
Signature of Pump Israiler

RECEIVED
Form: OLWR-SWR-18

NOV 0 9 2009

BY: OLWR