

County: Harrison  
 Permit #: MS-GW-16689  
 Driller: Griner Drilling Service, Inc.  
 Date drilling completed: 04/18/10

### State Well Report

#### Part 1 - Driller's Log

Mississippi Department of Environmental Quality  
 Office of Land and Water Resources  
 P.O. Box 2309  
 Jackson, MS 39225  
 (601)961-5210  
 (601)961-5228 (fax)

**For Office Use Only:**  
 Aquifer: \_\_\_\_\_  
 Well #: C396  
 L. S. Elevation: \_\_\_\_\_  
 E-log #: \_\_\_\_\_

**State Law requires that this report be prepared by the license holder responsible for the work and filed with the Department at the above address within 30 days of completion of drilling of the well or borehole.**

Information on Well Owner <i>(Landowner if borehole is not for a water well)</i>	Well or Borehole Location
Owner Name: <u>Harrison County Utility Authority</u>	Latitude: <u>30°35'28.66"N</u> Longitude: <u>89° 7'42.44"W</u>
Mailing Address: <u>10271 Express Drive</u>	Method of Lat/Long (check one): Conventional Survey <input type="radio"/> <sup>.29</sup>
<u>Gulfport</u> <u>MS</u> <u>39503</u>	USGS quad <input type="radio"/> Hand-held GPS <input checked="" type="radio"/> Survey-grade GPS <input type="radio"/> <sup>42</sup>
City State Zip Code	<u>SW 1/4 SE 1/4</u> Sec <u>19</u> ✓ Twn <u>5S</u> ✓ Rng <u>11W</u> ✓
Telephone No. ( ) _____	Distance Direction Nearest Town <u>3</u> Miles <u>N</u> of <u>Saucier</u>
	<u>Adams Road Well</u>

**Well / Borehole Data**

Date drilling started: 04/08/10 Date drilling completed: 04/18/10 Hole depth: 2000' Hole diameter: 24"

Location of the source of any surface water used for drilling: \_\_\_\_\_  
 Method of dosing and volume of Chlorine used in drilling and development: \_\_\_\_\_

Logs run (check all applicable): None  Electric  Gamma Ray  Density  Sonic  Neutron  Other: \_\_\_\_\_  
 Name of organization running log(s): Griner Drilling Service, Inc.

Purpose of borehole (check one): Water Well  Geotechnical/Geological Investigation  Ground Source Heat Pump   
 Seismic Survey  Other (describe) \_\_\_\_\_

***If drilling is not related to water well construction, skip the remainder of this block***

---

Purpose of Well (check one): Home  Industrial  Public Supply  Irrigation  Fish Culture  Other: \_\_\_\_\_

If a flowing well, method of flow regulation: Valve  Other (describe) \_\_\_\_\_

Static Water Level: 48.98 feet above  or below  land surface Date measured: 09/30/11

Method of Measurement (check one) steel tape  electric tape  air line  other: \_\_\_\_\_

Well depth: 1700' Well grouted to a depth of 1580 feet Type of grout (check one): Neat Cement  Bentonite  Mix

Casing length: 1580 feet Casing diameter: 16 inches Type of casing: Steel

Screen length: 100 feet Screen diameter: 10 3/4 inches Type of screen: Stainless Steel

Screen slot size: .020 inches Setting depth: From 1590 feet to 1690 feet

Type of completion (check all applicable): Gravel packed  Underreamed  Telescoped  Open hole   
 Natural Development  Other (describe): \_\_\_\_\_

Top of lap pipe or reduction in casing: \_\_\_\_\_ feet. ***If telescoped or more than one screen, describe on next page***

Form: OLWR-S

**RECEIVED**

OCT 14 2011

**BY: OLWR**

The sketch below only required for water wells

If well telescopes, show depths on sketch.

Ground Level  $\rightarrow$

see attached

If more than one screen, show location of each on sketch

Description of formations encountered must be provided for all wells and boreholes, unless specifically exempted by regulations

Description of Formations Encountered	From (depth)	To (depth)
Sand, Clay	Ground Level	30'
Sand	30'	60'
Sand, Clay	60'	100'
Clay	100'	140'
Sand	140'	168'
Clay	168'	650'
Sand	650'	690'
Clay	690'	706'
Sand	706'	730'
Clay	730'	758'
Sand	758'	790'
Clay	790'	800'
Sand	800'	848'
Clay	848'	884'
Sand, Clay	884'	938'
Clay	938'	1180'
Sand, Clay	1180'	1218'
Clay	1218'	1518'
Sand, Clay	1518'	1538'
Sand	1538'	1568'
Clay	1568'	1582'
Sand	1582'	1720'
Clay	1720'	1746'
Sand	1746'	1870'
Clay & Sand	1870'	1882'
Clay	1882'	2000'

Sketch the property layout and include the following: 1) the well location; 2) any permanent structures on the property that may aid in locating the well; 3) any roads, power lines, or other items that may aid in locating the property and the well; 4) a north arrow.

see attached

Landowner Name: \_\_\_\_\_

Form: OLWR-SWR-1A (04/08)

I certify that the well/borehole was drilled, constructed, and completed in accordance with all applicable requirements of the Mississippi Department of Environmental Quality and the Mississippi Department of Health regulations, if applicable, and state laws.

Charles H. Griner Sr. 0-184

10/11/11

Charles H. Griner **RECEIVED**

Print Name of Responsible Licensee and License No.

Date

Signature of Licensee

OCT 14 2011

BY: OLWR

# STATE WELL REPORT

## Part 2

**Pump Installer's Completion Report**  
Mississippi Department of Environmental Quality  
Office of Land and Water Resources  
P.O. Box 2309  
Jackson, MS 39225  
(601)961-5210  
(601)961-5228 (fax)

County: Harrison  
Permit #: \_\_\_\_\_  
Driller: Griner Drilling Service, Inc.  
Date completed: 04/18/10  
*Copy information from block on Part 1*

**For Office Use Only:**  
Aquifer: \_\_\_\_\_  
Well #: 1396  
Elevation: \_\_\_\_\_

*This part of the report must be completed by a licensed water well contractor or a licensed pump installer. A copy of Part 1 of the report must be attached and both parts filed with the Department at the above address within 30 days of well completion.*

Well Owner Information	Well Location
Owner Name: <u>Hancock County Utility Authority</u>	Latitude: <u>30°35'28.66"N</u> Longitude: <u>89° 7'42.44"W</u>
Mailing Address: <u>10271 Express Drive</u>	Method of Lat/Long (check one): Conventional Survey <input type="radio"/>
<u>Gulfport MS 39503</u>	USGS quad <input type="radio"/> Hand-held GPS <input checked="" type="radio"/> Survey-grade GPS <input type="radio"/>
City State Zip Code	<u>S10 1/4 SE 1/4 Sec 19 T 5S R 11W</u>
Telephone No. ( ) _____	Distance Direction Nearest Town <u>3</u> Miles <u>N</u> of <u>Saucier</u>

Pump Type	Power Type
Check one	Check one
Air Lift <input type="radio"/> Jet <input type="radio"/> Submersible <input type="radio"/>	Diesel Engine <input type="radio"/> Gasoline Engine <input type="radio"/> Natural Gas <input type="radio"/>
Bucket <input type="radio"/> Piston <input type="radio"/> Turbine <input checked="" type="radio"/>	Electric Motor <input checked="" type="radio"/> Hand <input type="radio"/> Tractor PTO <input type="radio"/>
Centrifugal <input type="radio"/> Rotary <input type="radio"/> Flowing Well <input type="radio"/>	Windmill <input type="radio"/> Other (specify): _____
Other (specify): _____	Horse Power Rating of Motor: <u>125</u>
Date Pump Installed: <u>01/03/11</u>	Setting Depth: <u>122</u> feet
Rated Pump Capacity: <u>1500</u> Gallons Per Minute	Number of Stages: <u>5</u>

Pump Test Data	Method of Measuring Water Level
Date Well Tested: <u>09/30/11</u>	Check one
Static Water Level (A): <u>48.98</u> Feet Below Land Surface	Air Line <input checked="" type="radio"/> Electric Measuring Line <input type="radio"/> Steel Tape <input type="radio"/>
Pumping Water Level (B): <u>76.31</u> Feet Below Land Surface	Other (specify): _____
Drawdown [(B) - (A)]: <u>27.33</u> Feet Below Land Surface	For flowing well, measured shut in head: _____ feet
Test Pumping Rate: <u>1800</u> Gallons Per Minute	Well yielded <u>1800</u> GPM with a drawdown of
Duration of Pump Test (minimum 4 hours): <u>24</u> hours	<u>27.33</u> feet after <u>24</u> hours of pumping


This is for (check one): New Well  Replacement of Existing Pump  Repair of Existing Pump

I HEREBY CERTIFY that the above statements are true to the best of my knowledge.  
Charles H. Griner Sr. 0-184  
Print Name of Pump Installer and License No. (if applicable) Signature of Pump Installer

RECEIVED  
OCT 14 2011  
BY: OLWR

C396

Harrison County Utility Authority  
W-11 Adams Road  
2010  
Permanent Potable Well

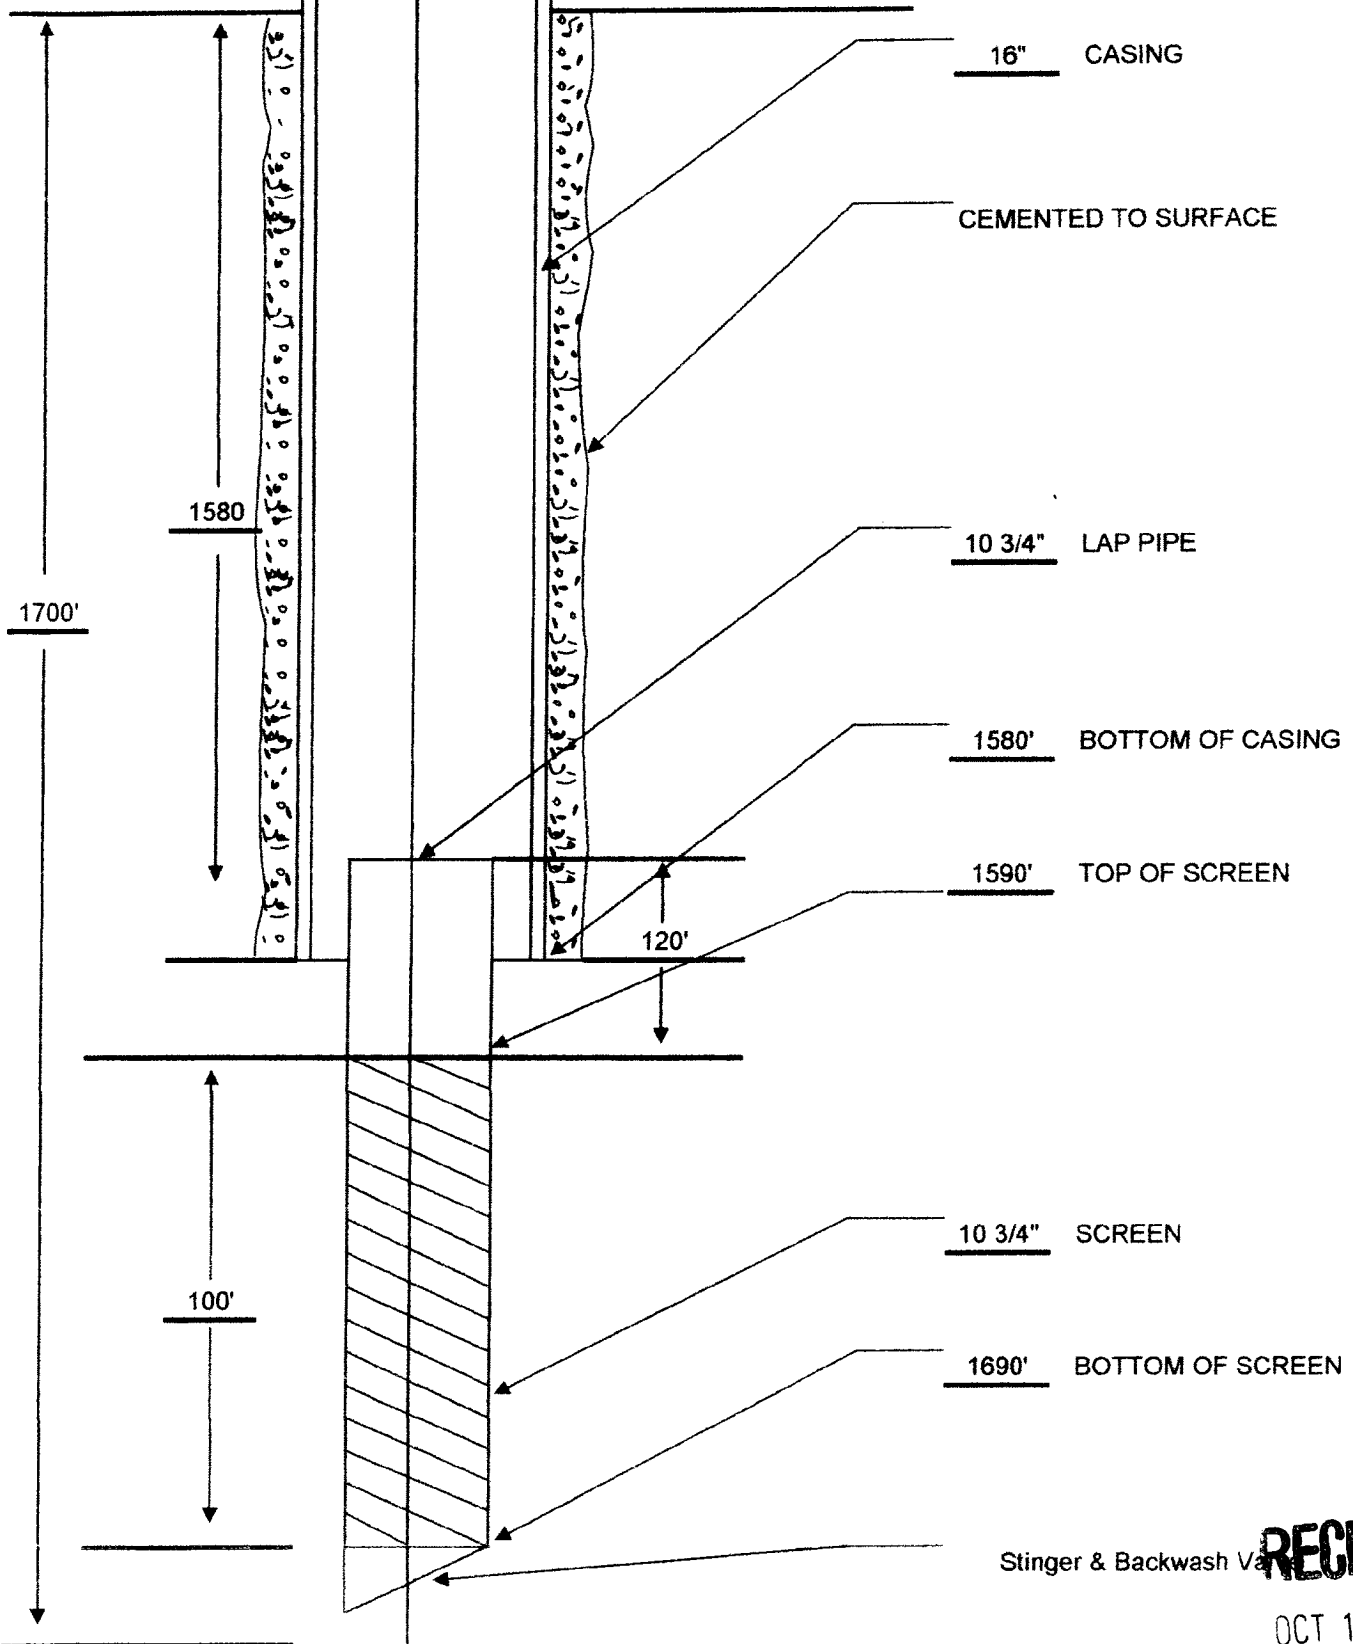

**RECEIVED**

OCT 14 2011

BY: OLWR

Harrison Co. C396



RECEIVED  
OCT 14 2011  
BY: OLWR