

Harrison
 C
 2000

MISSISSIPPI
 BOARD OF WATER COMMISSIONERS
 416 North State Street
 Jackson, Mississippi 39201

WATER WELL DRILLERS LOG

11-7-84 19 P. J. Moore HARRISON
 date well completed firm name county well located

LANDOWNER: FRANK DeCOIT

ORANGE GROVE RD

GULFPORT, MS
 (mailing address)

WELL LOCATION:
 sec 7 T 5 N R 11 E
1 1/2 miles W of Orange Grove
 (distance) (direction) (nearest town)

WELL PURPOSE:
 (home) irrigation, municipal, industrial

WELL COMPLETION DATA:

- (1) diameter (inches) 2"
- (2) total depth (feet) 580'
- (3) static water level (feet) 56' (below) above top of ground.
- (4) casing PVC, 580'
 (material) (depth)
 (size) If telescope see back.
- (5) screen 10', 580'
 (length) (depth to top)
2", PVC
 (size) (material)
- (6) pump 1, 8
 (HP) (yield gpm)
E
 (type power)
- (7) electric log (yes or no)
- (organization running log)
- (8) how well bottom plugged By
Howe

description of formations encountered	from	to
<u>TOP Soil</u>	<u>0</u>	<u>10</u>
<u>White Clay & Red</u>	<u>10</u>	<u>20</u>
<u>TOP Rusty Sand</u>		
<u>Fine loam</u>	<u>30</u>	<u>90</u>
<u>Blue Clay</u>	<u>90</u>	<u>200</u>
<u>GRAY FINE Sand</u>	<u>200</u>	<u>230</u>
<u>Blue Clay</u>	<u>230</u>	<u>400</u>
<u>med Sand</u>	<u>400</u>	<u>440</u>
<u>Blue Clay</u>	<u>440</u>	<u>500</u>
<u>Gray Sand med</u>	<u>500</u>	<u>560</u>
<u>" " coarse</u>	<u>560</u>	<u>580</u>

DEPT. OF NATURAL RESOURCES
 BUREAU OF LAND & WATER RESOURCES


NOV 16 1984

RECEIVED

DRILLERS REMARKS:

If well telescopes please sketch and show depths.

GROUND LEVEL

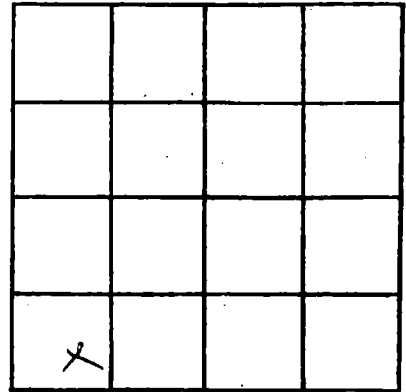

SECTION _____

Please indicate well location X.

ADDITIONAL INFORMATION

If more than one screen, show locations of each on sketch.