

MISSISSIPPI DEPARTMENT OF NATURAL RESOURCES

Bureau of Land and Water Resources

Southport Mall

P.O. Box 10631

Jackson, Mississippi 39209

WATER WELL DRILLERS LOG

Harrison
C
2005

1-13 1983 Frank Prie Harrison
 date well completed firm name county well located

LANDOWNER:	description of formations encountered	from	to
<u>M. D. Cleveland</u>	<u>Top Soil</u>	<u>0</u>	<u>2</u>
(mailing address)	<u>Red Sandy Clay</u>	<u>2</u>	<u>35</u>
WELL LOCATION:	<u>Blue Clay</u>	<u>35</u>	<u>80</u>
sec <u>30</u> T <u>5</u> R <u>11</u>	<u>Course Sand</u>	<u>80</u>	<u>320</u>
<u>2 1/2</u> miles <u>S</u> of <u>Sauces</u>			
(distance) (direction) (nearest town)			
WELL PURPOSE: <u>HOME</u>			
(home, irrigation, municipal, industrial)			
WELL COMPLETION DATA:			
(1) diameter (inches) <u>2"</u>			
(2) total depth (feet) <u>320'</u>			
(3) static water level (feet) <u>35'</u> below top of ground			
(4) casing <u>Plastic</u> <u>310'</u> (material) (depth)			
(size) If telescope see back.			
(5) screen <u>10'</u> <u>310'</u> (length) (depth to top)			
<u>2"</u> <u>Plastic</u> (size) (material)			
(6) pump <u>1</u> <u>9</u> (HP) (yield gpm)			
<u>Elect</u> (type power)			
(7) electric log <u>NO</u> (yes or no)			
(organization running log)			
(8) how well bottom plugged <u>Backwash valve</u>			
DRILLERS REMARKS:			


DEPT. OF NATURAL RESOURCES
 BUREAU OF LAND & WATER RESOURCES

FEB - 4 1983

RECEIVED

If well telescopes please sketch and show depths.

GROUND LEVEL

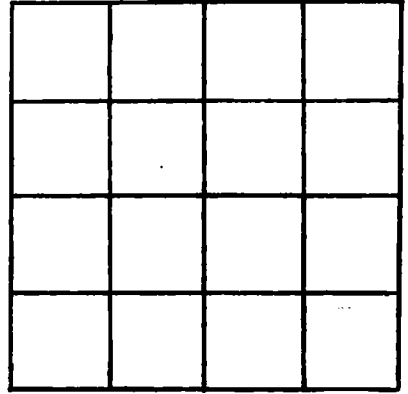

SECTION _____

Please indicate well location X.

ADDITIONAL INFORMATION

If more than one screen, show locations of each on sketch.