

MISSISSIPPI DEPARTMENT OF NATURAL RESOURCES

Bureau of Land and Water Resources

Southport Mall

P.O. Box 10631

Jackson, Mississippi 39209

WATER WELL DRILLERS LOG

Harrison
C
2006

Nov. 18

1982

Mercon Well Drilling

Harrison

date well completed

firm name

county well located

LANDOWNER: Michele Alaversa
3002 Vaughn St.
Biloxi, Ms.
(mailing address)

description of formations encountered

from

to

Clay	0	30
Clay & Sand mixed	30	120
Blue clay	120	150
fine sand	150	180
course sand	180	210

WELL LOCATION:

sec. 21 T. 5 N. R. 11 E.
(S) (W)
5 miles S.E. of Sauvies
(distance) (direction) (nearest town)

WELL PURPOSE: Home
(home, irrigation, municipal, industrial)

WELL COMPLETION DATA:

- (1) diameter (inches) 2"
- (2) total depth (feet) 210 ft.
- (3) static water level (feet) 28' below top of ground.
- (4) casing PVC, 200
(material) (depth)
2" if telescope see back.
(size)
- (5) screen 10', 200
(length) (depth to top)
2", PVC
(size) (material)
- (6) pump 1, 8
(HP) (yield gpm)
electric
(type power)
- (7) electric log
(yes or no)

DEPT. OF NATURAL RESOURCES
BUREAU OF LAND & WATER RESOURCES

JAN 21 1983

RECEIVED


(organization running log)

(8) how well bottom plugged sand
shale

DRILLERS REMARKS:

If well telescopes please sketch and show depths.

GROUND LEVEL

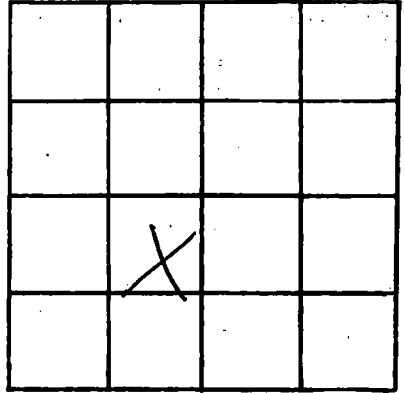

SECTION 21

Please indicate well location X.

ADDITIONAL INFORMATION

If more than one screen, show locations of each on sketch.