

MISSISSIPPI DEPARTMENT OF NATURAL RESOURCES

Bureau of Land and Water Resources

Southport Mall

P.O. Box 10631

Jackson, Mississippi 39209

COASTAL DRILLING & SERVICE CO.

ROUTE 1 BOX 618

BILOXI, MISS. 39532

Hansen  
C  
2008

Hansen  
county well located

3/12/82  
date well completed

LANDOWNER: John Tomberley  
Pt 2 Box 224  
Jacques Wood  
(mailing address)

description of formations encountered

from to

|                        |            |            |
|------------------------|------------|------------|
| <u>top soil</u>        | <u>1</u>   | <u>3</u>   |
| <u>red sand</u>        | <u>3</u>   | <u>15</u>  |
| <u>white sand</u>      | <u>15</u>  | <u>60</u>  |
| <u>SM Blue Clay</u>    | <u>60</u>  | <u>160</u> |
| <u>red blue clay</u>   | <u>160</u> | <u>315</u> |
| <u>fine water sand</u> | <u>315</u> | <u>360</u> |
| <u>good water sand</u> | <u>360</u> | <u>380</u> |

WELL LOCATION:

sec 33 T. 5 N R. 11 E  
S  
Saucier Creek  
(distance) (direction) (nearest town)

WELL PURPOSE:

(home, irrigation, municipal, industrial) home

WELL COMPLETION DATA:

- (1) diameter (inches) 2"
- (2) total depth (feet) 380'
- (3) static water level (feet) 80' below top of ground above
- (4) casing PX, 370'  
(material) (depth)
- (size) If telescope see back.
- (5) screen 10, 370'  
(length) (depth to top)
- 24  
(size) PX  
(material)
- (6) pump 1/2 10  
(HP) (yield gpm)
- Ele  
(type power)
- (7) electric log no  
(yes or no)

(organization running log)

(8) how well bottom plugged 2" ball valve sealed

DRILLERS REMARKS: 1982


DEPT. OF NATURAL RESOURCES  
BUREAU OF LAND & WATER RESOURCES

OCT 14 1982

RECEIVED

If well telescopes please sketch and show depths.

GROUND LEVEL

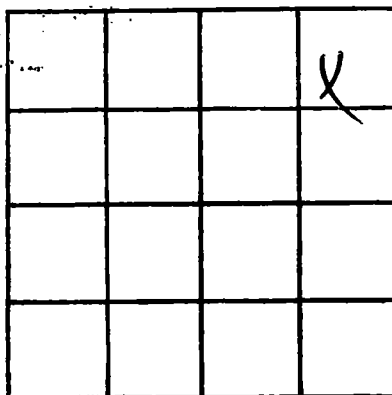

SECTION \_\_\_\_\_

Please indicate well location X.

ADDITIONAL INFORMATION

If more than one screen, show locations of each on sketch.