

MISSISSIPPI DEPARTMENT OF NATURAL RESOURCES

Bureau of Land and Water Resources

Southport Mall

P.O. Box 10631

Jackson, Mississippi 39209

WATER WELL DRILLERS LOG

HARRISON  
C  
2013

7/1/86 19 Lyman Well Harrison  
 date well completed firm name county well located

LANDOWNER: Robert Carden

Rt. 2, Lyman Rd.  
Sauvier, MS 39574  
 (mailing address)

WELL LOCATION:

sec. 21 T. 5 N. R. 11 E  
5 miles E of Sauvier  
 (distance) (direction) (nearest town)

WELL PURPOSE: home  
 (home, irrigation, municipal, industrial)

WELL COMPLETION DATA:

- (1) diameter (inches) 2"
- (2) total depth (feet) 90'
- (3) static water level (feet) 25' <sup>below</sup> ~~above~~ top of ground.
- (4) casing PVC, 80'  
 (material) (depth)  
2" if telescope see back.  
 (size)
- (5) screen 10', 80'  
 (length) (depth to top)  
2", PVC  
 (size) (material)
- (6) pump 1 7  
 (HP) (yield gpm)  
electric  
 (type power)
- (7) electric log No  
 (yes or no)  
No  
 (organization running log)
- (8) how well bottom plugged sand  
shark

description of formations encountered	from	to
Top soil		1'
Sand Redd Yellow clay	1'	11'
Redd - Silt	11'	46'
Redd Yellow Clay	46'	62'
Silt	62'	90'

**RECEIVED**


OCT 28 1986

Department of Natural Resources  
 Bureau of Land & Water Resources

DRILLERS REMARKS:

If well telescopes please sketch and show depths.

GROUND LEVEL

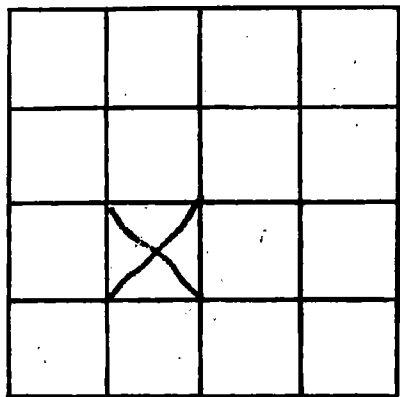

SECTION 21

Please indicate well location X.

ADDITIONAL INFORMATION

If more than one screen, show locations of each on sketch.