

MISSISSIPPI DEPARTMENT OF NATURAL RESOURCES

Bureau of Land and Water Resources

Southport Mall

P.O. Box 10631

Jackson, Mississippi 39209

WATER WELL DRILLERS LOG

HARRISON
C
214

7/7/86 19 Lyman Well Harrison
 date well completed firm name county well located

LANDOWNER: A.C. Parker
Rt. 1, Box 538
Saucier, MS 39574
 (mailing address)

WELL LOCATION:
 sec. 36 T. 5 N. R. 11 E.
20 miles N of Got
 (distance) (direction) (nearest town)

WELL PURPOSE: home
 (home, irrigation, municipal, industrial)

WELL COMPLETION DATA:

(1) diameter (inches) 2"

(2) total depth (feet) 150'

(3) static water level (feet) 38' below above top of ground.

(4) casing PVC 140'
 (material) (depth)

2" if telescope see back.
 (size)

(5) screen 10' 140'
 (length) (depth to top)

2" PVC
 (size) (material)

(6) pump N/A
 (HP) (yield gpm)

(type power)

(7) electric log No
 (yes or no)

No
 (organization running log)

(8) how well bottom plugged sand
Shark

description of formations encountered	from	to
Topsoil		1'
Yellow & white Clay	1'	18'
Sand	18'	26'
White Clay	26'	43'
Scanty Clay	43'	58'
Blue Clay	58'	132'
Sand	132'	150'

RECEIVED


OCT 28 1986

Department of Natural Resources
 Bureau of Land & Water Resources

DRILLERS REMARKS:

If well telescopes please sketch and show depths.

GROUND LEVEL

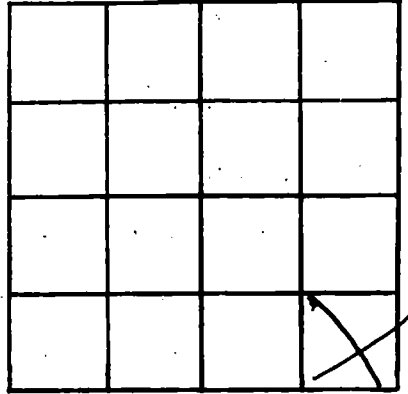

SECTION 36

Please indicate well location X.

ADDITIONAL INFORMATION

If more than one screen, show locations of each on sketch.