

MISSISSIPPI DEPARTMENT OF NATURAL RESOURCES

Bureau of Land and Water Resources

Southport Mall

P.O. Box 10631

Jackson, Mississippi 39209

WATER WELL DRILLERS LOG

HARRISON
C 2015

5/28/85
date well completed

Lyman Well Co
firm name

Harrison
county well located

LANDOWNER: Elizabeth Broadus
Rt. 2, Box 118
Saucier, MS 39574
(mailing address)

description of formations encountered	from	to
	red clay	0
white clay	40	80
blue clay	80	150
sand coarse	150	160

WELL LOCATION:

sec. 32 T 4 N R 11 E
5 miles west of Saucier
(distance) (direction) (nearest town)

WELL PURPOSE: house well
(home, irrigation, municipal, industrial)

WELL COMPLETION DATA:

- (1) diameter (inches) 2"
- (2) total depth (feet) 160'
- (3) static water level (feet) 50' below top of ground
- (4) casing PVC 150' (material) (depth)
2" (size) if telescope see back.
- (5) screen 10' 150' (length) (depth to top)
2" (size) PVC (material)
- (6) pump 1 (HP) 12 (yield gpm)
electric (type power)
- (7) electric log NO (yes or no)
NO (organization running log)
- (8) how well bottom plugged sand shark


RECEIVED
AUG 20 1985

DRILLERS REMARKS:

Department of Natural Resources
Bureau of Land & Water Resources

If well telescopes please sketch and show depths.

GROUND LEVEL

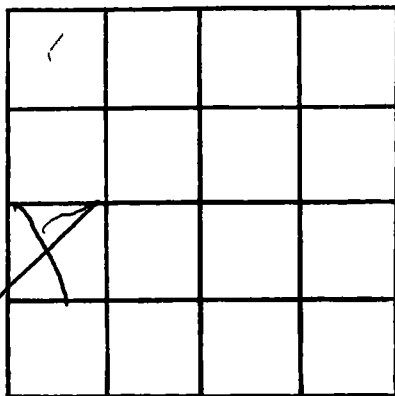

SECTION 32

Please indicate well location X.

ADDITIONAL INFORMATION

If more than one screen, show locations of each on sketch.