

MISSISSIPPI DEPARTMENT OF NATURAL RESOURCES

Bureau of Land and Water Resources

Southport Mall

P.O. Box 10631

Jackson, Mississippi 39209

WATER WELL DRILLERS LOG

HARRISON
C2016

6-28-85
date well completed

19 Mc Hill Pump & Well
firm name

Harrison
county well located

LANDOWNER: Betty West

Rt. 3 Box 547

Southport, Mo. 39503
(mailing address)

WELL LOCATION:

sec. 32 T. 5 N R. 11 E
6 miles NE of SAUCIER
(distance) (direction) (nearest town)

WELL PURPOSE:

(home, irrigation, municipal, industrial)

WELL COMPLETION DATA:

- (1) diameter (inches) 2"
- (2) total depth (feet) 320'
- (3) static water level (feet) 80' below top of ground
- (4) casing 3/4" Sch. 40 PVC, 310' (material) (depth)
- (5) screen 10' (length), 310' (depth to top)
- (6) pump 2" (size), Sch. 80 PVC - 6 slot (material)
- (7) pump 1 (HP), 7 (yield gpm)
- (8) electric log ELEC (type power)
- (9) electric log (yes or no)

(organization running log)

(8) how well bottom plugged sand SHARK

DRILLERS REMARKS:


description of formations encountered	from	to
Mud	0	140
Mud / Sand	140	160
Sand / Mud	160	180
Mud	180	220
Mud / Sand	220	240
Sand / Mud	240	260
Mud	260	280
Mud / Sand	280	300
Sand / Gravel	300	320

RECEIVED
JUL 8 - 1985

Department of Natural Resources
Bureau of Land & Water

If well telescopes please sketch and show depths.

GROUND LEVEL

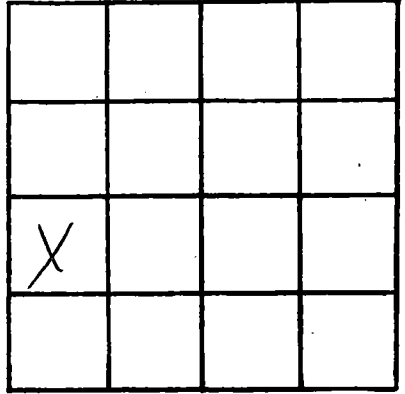

SECTION _____

Please indicate well location X.

ADDITIONAL INFORMATION

If more than one screen, show locations of each on sketch.