

MISSISSIPPI DEPARTMENT OF NATURAL RESOURCES

Bureau of Land and Water Resources

Southport Mall

P.O. Box 10631

Jackson, Mississippi 39209

WATER WELL DRILLERS LOG

HARRISON
C 2017

7-15-85

date well completed

1985

Mc Hill Pump Well Harrison

firm name

county well located

LANDOWNER:

John W. James

description of formations encountered

from

to

P.O. Box 1015

Southport, Mo. 39502
(mailing address)

Mud	0	120
Mud/Sand	120	140
Mud	140	160
Mud/Sand	160	180
Sand	180	200

WELL LOCATION:

sec. 32 T. 4 N. R. 11 E.
4 miles NE of SAUCIER
(distance) (direction) (nearest town)

WELL PURPOSE:

(home, irrigation, municipal, industrial)

WELL COMPLETION DATA:

- (1) diameter (inches) 4"
- (2) total depth (feet) 200'
- (3) static water level (feet) 65' below top of ground.
- (4) casing Sel. 40 Pvc, 190'
(material) (depth)
- (size) if telescope see back.
- (5) screen 10', 190'
(length) (depth to top)
- 4" Sel. 80 PVC
(size) (material)
- (6) pump 1 (HP) 18 (yield gpm)
- Elec
(type power)
- (7) electric log (yes or no)
- (organization running log)

(8) how well bottom plugged Sand Seal


DRILLERS REMARKS:

RECEIVED
AUG 20 1985

Department of Natural Resources
Bureau of Land & Water Resources

If well telescopes please sketch and show depths.

GROUND LEVEL

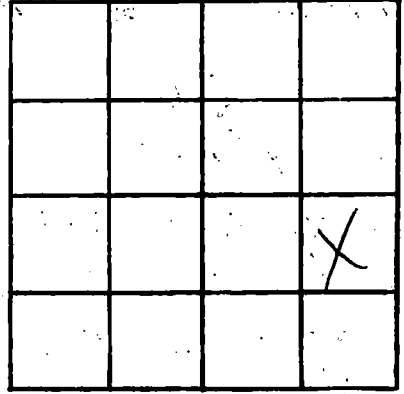

SECTION _____

Please indicate well location X.

ADDITIONAL INFORMATION

A series of horizontal lines for writing additional information.

If more than one screen, show locations of each on sketch.