

MISSISSIPPI DEPARTMENT OF NATURAL RESOURCES
Bureau of Land and Water Resources
 Southport Mall
 P.O. Box 10631
 Jackson, Mississippi 39209
WATER WELL DRILLERS LOG

C 2019
HARRISON
8-31-85

8-31-85 19 Riv. Mooka HARRISON
 date well completed firm name county well located

LANDOWNER: HAZEL CEMALICE
Structure, MS

description of formations encountered	from	to
<u>TOP SOIL</u>	<u>0</u>	<u>10</u>
<u>White & Red Clay</u>	<u>10</u>	<u>100</u>
<u>Blue Clay</u>	<u>100</u>	<u>260</u>
<u>COARSE SAND</u>	<u>260</u>	<u>300</u>

(mailing address)

WELL LOCATION:

sec. 18 T. 5 N. R. 11 E.
2 1/2 miles SE of Structure
 (distance) (direction) (nearest town)

WELL PURPOSE:

(home, irrigation, municipal, industrial)

WELL COMPLETION DATA:

- diameter (inches) 2"
- total depth (feet) 300
- static water level (feet) 20 below above top of ground.
- casing Pvc, 300,
 (material) (depth)
 (size) if telescope see back.
- screen 10', 300
 (length) (depth to top)
2", Pvc
 (size) (material)
- pump 1 6
 (HP) (yield gpm)
E
 (type power)
- electric log _____
 (yes or no)

 (organization running log)
- how well bottom plugged Partial


DRILLERS REMARKS:

RECEIVED
 OCT 10 1985

Department of Natural Resources
 Bureau of Land & Water

If well telescopes please sketch and show depths.

GROUND LEVEL

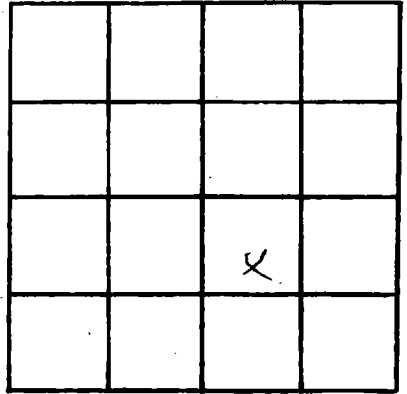

SECTION 18

Please indicate well location X.

ADDITIONAL INFORMATION

If more than one screen,
show locations of each on sketch.