

MISSISSIPPI DEPARTMENT OF NATURAL RESOURCES

Bureau of Land and Water Resources

Southport Mall

P.O. Box 10631

Jackson, Mississippi 39209

WATER WELL DRILLERS LOG

HARRISON

C 2020

4/12/85 ^{See Dr} Braden Pump & Well Harrison

date well completed

firm name

county well located

LANDOWNER: Pat Norma

Rt. 2, Box 64A

Sauvier, Mo 39574
(mailing address)

WELL LOCATION:

sec. 8 T. 5 N R. 11 E
2 miles SE of Sauvier
(distance) (direction) (nearest town)

WELL PURPOSE: Home
(home, irrigation, municipal, industrial)

WELL COMPLETION DATA:

- (1) diameter (inches) 2"
- (2) total depth (feet) 320
- (3) static water level (feet) 48 below above top of ground.
- (4) casing PVC, 300,
(material) (depth)
2" if telescope see back.
(size)
- (5) screen 10', 300
(length) (depth to top)
2", PVC
(size) (material)
- (6) pump 1, 10
(HP) (yield gpm)
230 V Ø
(type power)
- (7) electric log NO
(yes or no)

(organization running log)

(8) how well bottom plugged PVC sandstone

DRILLERS REMARKS: 10 ft tailpipe


description of formations encountered	from	to
Clay + gravel	0	20
sand + clay	20	60
Clay	60	220
Clay + sand	220	280
sand	280	300
sand + clay	300	320

RECEIVED
APR 23 1985

Department of Natural Resources
Bureau of Land & Water Resources

If well telescopes please sketch and show depths.

GROUND LEVEL

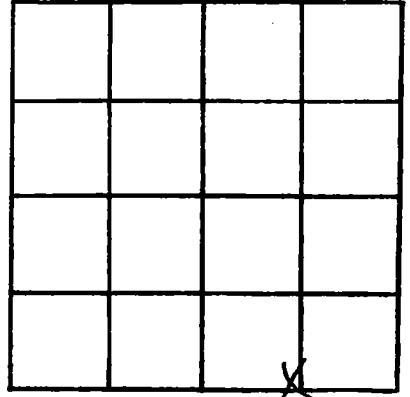

SECTION 8

Please indicate well location X.

ADDITIONAL INFORMATION

If more than one screen, show locations of each on sketch.