

## MISSISSIPPI DEPARTMENT OF NATURAL RESOURCES

Bureau of Land and Water Resources

Southport Mall

P.O. Box 10631

Jackson, Mississippi 39209

## WATER WELL DRILLERS LOG

Harrison

C 2023

5-20-85

5-20

1985

McGill Well Drills Harrison

date well completed

firm name

county well located

LANDOWNER: Nobles Auto Parts

description of formations encountered

from

to

Rt. 1 Box 795

Mud	0	30
Mud	30	40
Mud	40	60
Mud	60	80
Mud	80	100
Mud	100	120
Mud	120	140
Mud / Sand	140	160
Mud / Sand	160	180
Sand	180	200

WELL LOCATION:

sec. 14 T 5 N R 12 E

(S)

(W)

6 miles SE of SAUCIER

(distance)

(direction)

(nearest town)

WELL PURPOSE:

(home, irrigation, municipal, industrial)

WELL COMPLETION DATA:

(1) diameter (inches) 2"

(2) total depth (feet) 200'

(3) static water level (feet) 30 (below) above top of ground.

(4) casing PVC Sch. 40 190' (material) (depth)

(size) If telescope see back.

(5) screen 10' , 190' (length) (depth to top)

2" , Sch. 80, 6 plot (size) (material)

(6) pump 1 (HP) 9 (yield gpm)

Elec. (type power)

(7) electric log NO (yes or no)

(organization running log)

(8) how well bottom plugged Sand (material)


DRILLERS REMARKS:

RECEIVED

JUN 11 1985

If well telescopes please  
sketch and show depths.

**GROUND LEVEL**

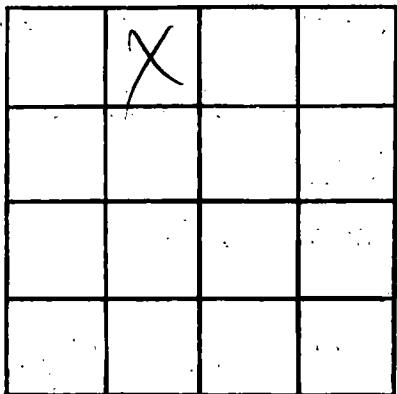

**SECTION** \_\_\_\_\_

Please indicate well location X.

**ADDITIONAL INFORMATION**

If more than one screen,  
show locations of each on sketch.