

MISSISSIPPI DEPARTMENT OF NATURAL RESOURCES

Bureau of Land and Water Resources

Southport Mall

P.O. Box 10631

Jackson, Mississippi 39209

WATER WELL DRILLERS LOG

Harrison
C 2023
4-18-85

4-18  
date well completed

1985 Frank Price  
firm name

Harrison  
county well located

LANDOWNER:  
Kenneth Cox  
  
(mailing address)

description of formations encountered	from	to
<u>Top Soil</u>	<u>0</u>	<u>2</u>
<u>Sandy clay</u>	<u>2</u>	<u>80</u>
<u>Course Sand</u>	<u>80</u>	<u>71</u>

WELL LOCATION:  
sec. 2 T. 5 S. R. 11 W.  
1/2 miles E of HWY 67  
(distance) (direction) (nearest town)

WELL PURPOSE: HOME  
(home, irrigation, municipal, industrial)

WELL COMPLETION DATA:

(1) diameter (inches) 2"

(2) total depth (feet) 71'

(3) static water level (feet) 40' below top of ground

(4) casing PVC 66'  
(material) (depth)  
  
if telescope see back.  
(size)

(5) screen 5', 66'  
(length) (depth to top)  
2", PVC  
(size) (material)

(6) pump 1 10  
(HP) (yield gpm)  
Elect  
(type power)

(7) electric log no  
(yes or no)  
  
(organization running log)

(8) how well bottom plugged  
BWV

DRILLERS REMARKS:


**RECEIVED**

JUN 1 8 1985

Department of Natural Resources  
Bureau of Land & Water Resources

If well telescopes please  
sketch and show depths.

GROUND LEVEL

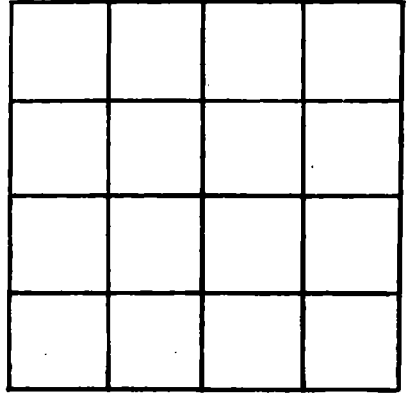

SECTION \_\_\_\_\_

Please indicate well location X.

ADDITIONAL INFORMATION

If more than one screen,  
show locations of each on sketch.