

MISSISSIPPI DEPARTMENT OF NATURAL RESOURCES

Bureau of Land and Water Resources

Southport Mall

P.O. Box 10631

Jackson, Mississippi 39209

WATER WELL DRILLERS LOG

Harrison  
C 2025  
4-5-85

4-5  
date well completed

1985 Frank Pice  
firm name

Harrison  
county well located

LANDOWNER:  
Lawrence Parker  
(mailing address)

description of formations encountered	from	to
Top Soil	0	2
Clay	2	175
Course Sand	175	183

WELL LOCATION:  
sec 32 T 4 R 11 S W  
1/2 miles N of HWY 67  
(distance) (direction) (nearest town)

WELL PURPOSE: HOME  
(home, irrigation, municipal, industrial)

- WELL COMPLETION DATA:
- (1) diameter (inches) 2"
  - (2) total depth (feet) 183
  - (3) static water level (feet) 70' below top of ground
  - (4) casing PVC, 173' (material) (depth)
  - (5) screen 10' length, 173' depth to top, 2" size, PVC material
  - (6) pump 1 HP, 7 yield gpm, Elect type power
  - (7) electric log no (yes or no)
  - (8) how well bottom plugged BWV


RECEIVED  
JUN 1 8 1985

Department of Natural Resources  
Bureau of Land & Water Resources

DRILLERS REMARKS:

If well telescopes please sketch and show depths.

GROUND LEVEL

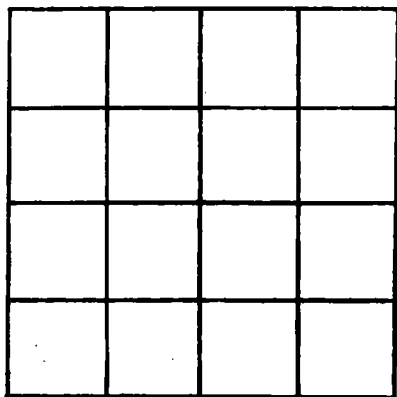

SECTION \_\_\_\_\_

Please indicate well location X.

ADDITIONAL INFORMATION

If more than one screen, show locations of each on sketch.