

MISSISSIPPI DEPARTMENT OF NATURAL RESOURCES

Bureau of Land and Water Resources

Southport Mall

P.O. Box 10631

Jackson, Mississippi 39209

WATER WELL DRILLERS LOG

Harrison
 C 2026
 5-28-85

5-28

19

Frank Price Harrison

date well completed

firm name

county well located

LANDOWNER:
 Dorothy Reeves
 (mailing address)

WELL LOCATION:
 sec. 26 T 4 R 11 S W
 2 miles S of Pheasant Town
 (distance) (direction) (nearest town)

WELL PURPOSE: HOME
 (home, irrigation, municipal, industrial)

WELL COMPLETION DATA:

(1) diameter (inches) 2"

(2) total depth (feet) 330

(3) static water level (feet) 150 below top of ground.

(4) casing PVC 320 (material) (depth)

(size) if telescope see back.

(5) screen 10' 320 (length) (depth to top)

2" PVC (size) (material)

(6) pump 2 (HP) 5 (yield gpm)

Elect (type power)

(7) electric log no (yes or no)

(organization running log)

(8) how well bottom plugged B W V

description of formations encountered	from	to
Top Soil	0	2
Red Clay	2	12
Sand	12	32
Clay	32	300
Course Sand	300	330


RECEIVED
 JUN 18 1985

Department of Natural Resources
 Bureau of Land & Water Resources

DRILLERS REMARKS:

If well telescopes please
sketch and show depths.

GROUND LEVEL

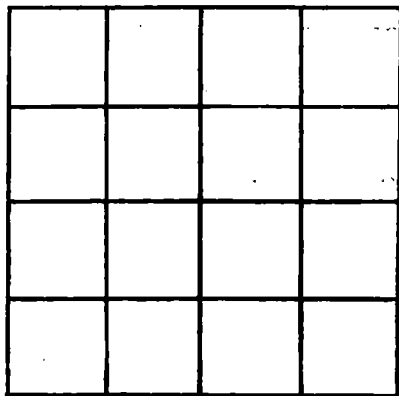

SECTION _____

Please indicate well location X.

ADDITIONAL INFORMATION

If more than one screen,
show locations of each on sketch.