

MISSISSIPPI DEPARTMENT OF NATURAL RESOURCES
 Bureau of Land and Water Resources
 Southport Mall
 P.O. Box 10631

L

Jackson, Mississippi 39209
WATER WELL DRILLERS LOG
COASTAL DRILLING & SERVICE CO.

Harrison
 C 2029
 6-15-84

6/15/84
 date well completed 19

RT. 14, BOX 01
 location

Harrison
 county well located

LANDOWNER: Jon James
Saucier MS.
 (mailing address)

description of formations encountered	from	to
top soil	1	3
red clay	3	10
sugar sand	10	50
hard blue clay	50	140
soft blue clay	140	260
good water sand	260	270
poor water sand	270	280

WELL LOCATION:
 sec. 25 T. 6 N. R. 11 E.
 S. W.
Saucier
 (distance) (direction) (nearest town)

WELL PURPOSE: home
 (home, irrigation, municipal, industrial)

- WELL COMPLETION DATA:
- diameter (inches) 2"
 - total depth (feet) 280'
 - static water level (feet) 10 below top of ground.
 - casing PVC, 270,
 (material) (depth)
 (size) if telescope see back.
 - screen 10, 270
 (length) (depth to top)
2", PVC
 (size) (material)
 - pump 1, 178
 (HP) (yield gpm)
etc.
 (type power)
 - electric log NO
 (yes or no)
 (organization running log)
 - how well bottom plugged 2" back
wash valve 19-B


RECEIVED
 JUL 22 1985

DRILLERS REMARKS:

Department of Natural Resources
 Bureau of Land & Water Resources

If well telescopes please sketch and show depths.

GROUND LEVEL.

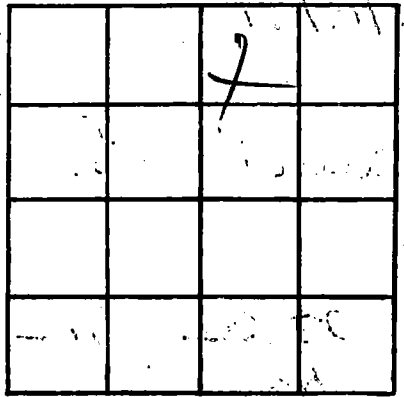

SECTION _____

Please indicate well location X.

ADDITIONAL INFORMATION

If more than one screen, show locations of each on sketch.