

MISSISSIPPI DEPARTMENT OF NATURAL RESOURCES

Bureau of Land and Water Resources

Southport Mall

P.O. Box 10631

Jackson, Mississippi 39209

WATER WELL DRILLERS LOG

Harrison
C
2035

10-8 1985 date well completed
McHill Pump & Well firm name
Harrison county well located

LANDOWNER: James D Bishop
St. 1 Box 698
Moselle, Mo. 39459
(mailing address)

WELL LOCATION:
sec. 17 T 5 N R 11 E
(S) (W)
3 miles SE of Saurin
(distance) (direction) (nearest town)

WELL PURPOSE:
(home, irrigation, municipal, industrial)

WELL COMPLETION DATA:
(1) diameter (inches) 2"
(2) total depth (feet) 440'
(3) static water level (feet) 110' below above top of ground.
(4) casing Sch. 40 PVC 430' (material) (depth)
(size) if telescope see back.
(5) screen 10' 430' (length) (depth to top)
2" Sch. 80 PVC - 6 slot (size) (material)
(6) pump 1 (HP) 7 (yield gpm)
Elec. (type power)
(7) electric log (yes or no)
(organization running log)
(8) how well bottom plugged Sand SHARK

description of formations encountered	from	to
Mud	0	40
Mud / sand	40	60
Sand	60	100
Mud	100	200
Sand / mud	200	220
Mud	220	360
Mud / sand	360	420
Sand	420	440


DRILLERS REMARKS:

RECEIVED
NOV 26 1985

Department of Natural Resources
Bureau of Land & Water Resources

If well telescopes please sketch and show depths.

GROUND LEVEL

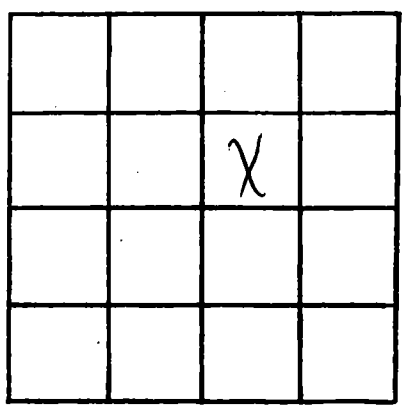

SECTION _____

Please indicate well location X.

ADDITIONAL INFORMATION

Lined area for additional information.

If more than one screen, show locations of each on sketch.